

CARD MUST BE TYPED

State of Kansas
NOTICE OF INTENTION TO DRILL
(see rules on reverse side)

CARD MUST BE SIGNED

Starting Date: January 16, 1985
month day year

API Number 15- 101-21,268-00-00

OPERATOR: License # 5104.....

NW... SW SW Sec 10.. Twp 18. S, Rge 27. East
(location) West

Name BLUE GOOSE DRILLING COMPANY, INC.,

Address P.O. Box 1413

City/State/Zip Great Bend, KS 67530

Contact Person Martin E. Miller

Phone 316-792-5633

..... 990..... Ft North from Southeast Corner of Section

..... 4950..... Ft West from Southeast Corner of Section

(Note: Locate well on Section Plat on reverse side)

CONTRACTOR: License # Same

Name Company tools

City/State

Nearest lease or unit boundary line 330 feet.

County Lane

Lease Name Neeley Well# 1

Domestic well within 330 feet : yes no

Municipal well within one mile : yes no

Well Drilled For: Well Class: Type Equipment:

Oil Swd Infield Mud Rotary

Gas Inj Pool Ext. Air Rotary

OWWO Expl Wildcat Cable

Depth to Bottom of fresh water 100 feet

Lowest usable water formation .. Dakota

Depth to Bottom of usable water 1000 feet

Surface pipe by Alternate : 1 2

Surface pipe to be set 240' feet

Conductor pipe if any required feet

Ground surface elevation feet MSL

This Authorization Expires 6-18-86

Approved By 12-18-85 E. [Signature]

If OWWO: old well info as follows:

Operator

Well Name

Comp Date Old Total Depth

Projected Total Depth 4650 feet

Projected Formation at TD Miss

Expected Producing Formations Cher. Sd.....

I certify that we will comply with K.S.A. 55-101, et seq., plus eventually plugging hole to K.C.C. specifications.


Date 12/16/85..... Signature of Operator or Agent [Signature]

Title Contract Representative

Must be filed with the K.C.C. five (5) days prior to commencing well
 This card void if drilling not started within six (6) months of date received by K.C.C.

Important procedures to follow :

A Regular Section of Land
1 Mile = 5,280 Ft.

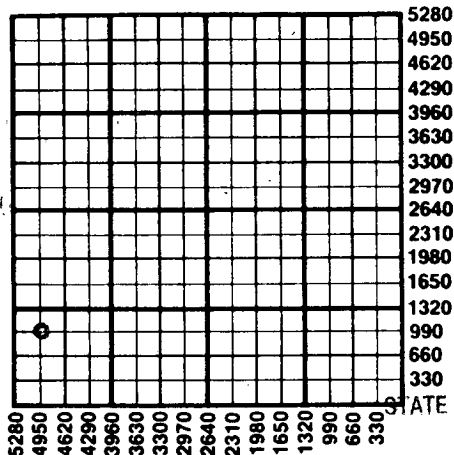

1. Notify District office before setting surface casing.
2. Set surface casing by circulating cement to the top.
3. File completion forms ACO-1 with K.C.C. within 90 days of well completion, following instructions on ACO-1, side 1, and including copies of wireline logs.
4. Notify District office 48 hours prior to old well workover or re-entry.
5. Prior to plugging, prepare a plugging plan, then obtain agreement from the appropriate district office for an approved plugging plan.
6. Submit plugging report (CP-4) to K.C.C. after plugging is completed.
7. Obtain an approved injection docket number before disposing of salt water.
8. Notify K.C.C. within 10 days when injection commences or terminates.

9. If an alternate 2 completion, cement in the production pipe from below any usable water to surface within 120 days of spud date.

RECEIVED
 STATE CORPORATION COMMISSION

DEC 18 1985
 12-18-1985
 CONSERVATION DIVISION
 Wichita, Kansas

State Corporation Commission of Kansas
 Conservation Division
 200 Colorado Derby Building
 Wichita, Kansas 67202
 (316) 263-3238