

CARD MUST BE TYPED

State of Kansas
NOTICE OF INTENTION TO DRILL

CARD MUST BE SIGNED

(see rules on reverse side)

Starting Date: 9 - 20 - 84
month day year

API Number 15- 101-21,050-0000

OPERATOR: License # 9152
Name MAREXCO
Address 3025 Quail Street
City/State/Zip Lakewood, Colorado 80215
Contact Person Steve Marden
Phone (303) 237-5716

SE NW SW 25 Sec 26. Twp 17. S, Rge 27. . East
(location) West

..... 1650!..... Ft North from Southeast Corner of Section
..... 4290!..... Ft West from Southeast Corner of Section
(Note: Locate well on Section Plat on reverse side)

CONTRACTOR: License #
Name Unknown
City/State

Nearest lease or unit boundary line 990 feet.
County Lane
Lease Name Repshire Well# 1-26...

Well Drilled For: Well Class: Type Equipment:
 Oil Swd Infield Mud Rotary
 Gas Inj Pool Ext. Air Rotary
 OWWO Expl Wildcat Cable

Domestic well within 330 feet: yes no
Municipal well within one mile: yes no

If OWWO: old well info as follows:

Operator
Well Name
Comp Date Old Total Depth
Projected Total Depth 4650 feet
Projected Formation at TD Mississippian
Expected Producing Formations Lansing - K.C.

Depth to Bottom of fresh water 150 feet
Lowest usable water formation Dakota
Depth to Bottom of usable water 1,100 feet
Surface pipe by Alternate: 1 2
Surface pipe to be set 325 feet
Conductor pipe if any required XX feet
Ground surface elevation feet MSL.
This Authorization Expires 3-14-85
Approved By 9-14-84 K.C.

I certify that we will comply with K.S.A. 55-101, et seq., plus eventually plugging hole to K.C.C. specifications.


Date 9/10/84 Signature of Operator or Agent *Stephen D. Marden* Title owner

m HC/KOHE 9/14/84 Form C-1 4/84

Must be filed with the K.C.C. five (5) days prior to commencing well
This card void if drilling not started within six (6) months of date received by K.C.C.

Important procedures to follow :

**A Regular Section of Land
1 Mile = 5,280 Ft.**

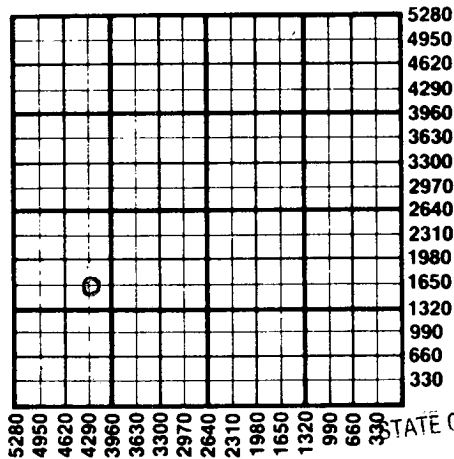

1. Notify District office before setting surface casing.
 2. Set surface casing by circulating cement to the top.
 3. File completion forms ACO-1 with K.C.C. within 90 days of well completion, following instructions on ACO-1, side 1, and including copies of wireline logs.
 4. Notify District office 48 hours prior to old well workover or re-entry.
 5. Prior to plugging, prepare a plugging plan, then obtain agreement from the appropriate district office for an approved plugging plan.
 6. Submit plugging report (CP-4) to K.C.C. after plugging is completed.
 7. Obtain an approved injection docket number before disposing of salt water.
 8. Notify K.C.C. within 10 days when injection commences or terminates.
9. If an alternate 2 completion, cement in the production pipe from below any production water to surface within 120 days of spud date.

RECEIVED
STATE CORPORATION COMMISSION

SEP 14 1984

CONSERVATION DIVISION
Wichita, Kansas

State Corporation Commission of Kansas
Conservation Division
200 Colorado Derby Building
Wichita, Kansas 67202
(316) 263-3238