

CARD MUST BE TYPED

State of Kansas

CARD MUST BE SIGNED

NOTICE OF INTENTION TO DRILL

(see rules on reverse side)

Starting Date October 14 1985
 month day year 3/48

OPERATOR: License # 5181
 Name SLAWSON, DONALD C.
 Address 200 Douglas Bldg.
 City/State/Zip Wichita, Kansas 67202
 Contact Person Bill Horigan
 Phone 316 263-3201

CONTRACTOR: License # 5657
 Name Slawson Drilling Co.
 City/State Wichita, Kansas

Well Drilled For:	Well Class:	Type Equipment:
<input checked="" type="checkbox"/> Oil	<input type="checkbox"/> SWD	<input checked="" type="checkbox"/> Mud Rotary
<input type="checkbox"/> Gas	<input type="checkbox"/> Inj	<input type="checkbox"/> Air Rotary
<input type="checkbox"/> OWWO	<input type="checkbox"/> Expl	<input checked="" type="checkbox"/> Wildcat
		<input type="checkbox"/> Cable

If OWWO: old well info as follows:

Operator
 Well Name
 Comp Date Old Total Depth

I certify that well will comply with K.S.A. 55-101, et seq., plus eventually plugging hole to KCC specifications.

_____ cementing will be done immediately upon setting production casing.

Date 10/11/85 Signature of Operator or Agent Robert B. Jenkins Title Western Kansas District Geologist

For KCC Use:

Conductor Pipe Required feet; Minimum Surface Pipe Required feet per Alt 1 2

This Authorization Expires 4-11-86 Approved By 10-11-85

The prod. csg. will be cmted
 from below useable wtr. to surf.
 immediately upon compl. of well.

API Number 15 101-21,240-0000 East
 S/2 SE, SW Sec. 24 Twp. 17 S, Rg. 27 X West
 330' Ft. from South Line of Section
 3300' Ft. from East Line of Section

(Note: Locate well on Section Plat on reverse side)

Nearest lease or unit boundary line 330' feet

County Lane

Lease Name Benson 'J' Well # 1

Ground surface elevation 2537 GR (Seis) feet MSL

Domestic well within 330 feet: yes no

Municipal well within one mile: yes no

Surface pipe by Alternate: 1 2 X

Depth to bottom of fresh water 90'

Depth to bottom of usable water 950'

Surface pipe planned to be set 320' of 8.5/8" 23# LSST&C

Projected Total Depth 4650' feet

Formation MISS

Must be filed with the K.C.C. five (5) days prior to commencing well
This card void if drilling not started within six (6) months of date received by K.C.C.

Important procedures to follow:

1. Notify District office before setting surface casing.
2. Set surface casing by circulating cement to the top.
3. File completion forms ACO-1 with K.C.C. within 90 days of well completion, following instructions on ACO-1, side 1, and including copies of wireline logs.
4. Notify District office 48 hours prior to old well workover or re-entry.
5. Prior to filing Intent, prepare a proposed plugging plan in case well is D & A, then obtain approval of plan when calling district office prior to setting surface pipe.
6. Submit plugging report (CP-4) to K.C.C. after plugging is completed.
7. Obtain an approved injection docket number before disposing of salt water.
8. Notify K.C.C. within 10 days when injection commences or terminates.
9. If an alternate 2 completion, cement in the production pipe from below any usable water to surface within 120 days of spud date.

RECEIVED


STATE CORPORATION COMMISSION

A Regular Section of Land
1 Mile = 5,280 Ft.

OCT 11 1985

CONSERVATION DIVISION

Wichita, Kansas

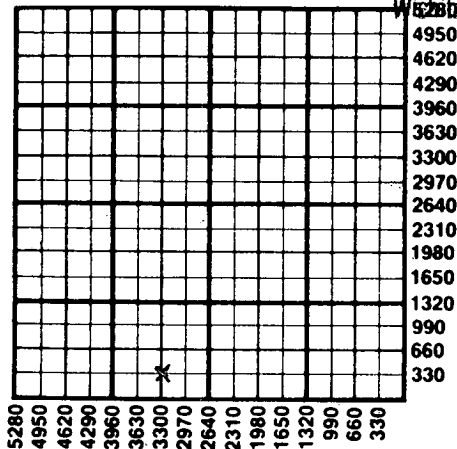

State Corporation Commission of Kansas

Conservation Division

200 Colorado Derby Building

Wichita, Kansas 67202

(316) 263-3238