

CARD MUST BE TYPED

State of Kansas
NOTICE OF INTENTION TO DRILL

CARD MUST BE SIGNED

(see rules on reverse side)

Starting Date: August 28 1984
month day year

API Number 15- 101-21,030-00-00

OPERATOR: License # 3886 Chief Drilling Co., Inc. E/2. NE. NW 34. Twp 17S. S. Rge 27. East West

Name 905 Century Plaza
Address Wichita, Kansas 67202

(location) 4620' Ft North from Southeast Corner of Section
2970' Ft West from Southeast Corner of Section
(Note: Locate well on Section Plat on reverse side)

City/State/Zip
Contact Person F. W. Shelton, Jr.
Phone (316) 262-3791

Nearest lease or unit boundary line 330' feet.
County Lane

CONTRACTOR: License # 5883
Name Warrior Drilling Co.
City/State 905 Century Plaza Wichita Ks

Lease Name Whipple Well# #2

Well Drilled For: Well Class: Type Equipment:
 Oil Swd Infield Mud Rotary
 Gas Inj Pool Ext. Air Rotary
 OWWO Expl Wildcat Cable

Domestic well within 330 feet: yes no
Municipal well within one mile: yes no

If OWWO: old well info as follows:

Operator
Well Name
Comp Date Old Total Depth
Projected Total Depth 4650 feet
Projected Formation at TD Mississippi
Expected Producing Formations Lansing & Cherokee

Depth to Bottom of fresh water 100 feet
Lowest usable water formation Lower Cretaceous
Depth to Bottom of usable water 700' 950 feet
Surface pipe by Alternate: 1 2
Surface pipe to be set 325 feet
Conductor pipe if any required none feet
Ground surface elevation will provide feet MSL
This Authorization Expires 2-24-85
Approved By 8-24-84

I certify that we will comply with K.S.A. 55-101, et seq., plus eventually plugging hole to K.C.C. specifications.


Date 8-28-84 Signature of Operator or Agent

Signature of F. W. Shelton, Jr.
Title Vice President

MHC/JUDITH 8/24/84

**Must be filed with the K.C.C. five (5) days prior to commencing well
 This card void if drilling not started within six (6) months of date received by K.C.C.**

**A Regular Section of Land
 1 Mile = 5,280 Ft.**

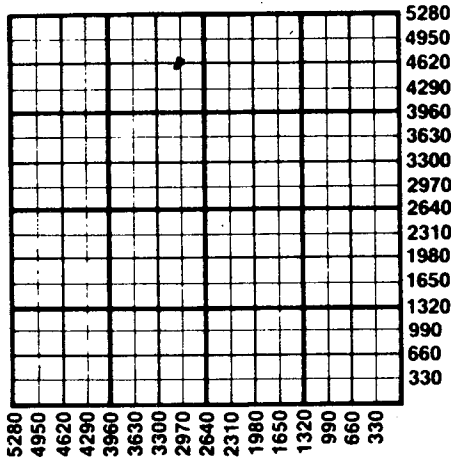

Important procedures to follow:

1. Notify District office before setting surface casing.
2. Set surface casing by circulating cement to the top.
3. File completion forms ACO-1 with K.C.C. within 90 days of well completion, following instructions on ACO-1 and including copies of wireline logs.
4. Notify District office 48 hours prior to old well workover or re-entry.
5. Prior to plugging, prepare a plugging plan, then obtain agreement from the appropriate district office for an approved plugging plan.
6. Submit plugging report (CP-4) to K.C.C. after plugging is completed.
7. Obtain an approved injection docket number before disposing of salt water.
8. Notify K.C.C. within 10 days when injection commences or terminates.
9. If an alternate 2 completion, cement in the production pipe from below any usable water to surface within 120 days of spud date.

RECEIVED
 STATE CORPORATION COMMISSION

AUG 24
 60/15/46
 CONSERVATION DIVISION
 Wichita, Kansas

**State Corporation Commission of Kansas
 Conservation Division
 200 Colorado Derby Building
 Wichita, Kansas 67202
 (316) 263-3238**