


STATE OF KANSAS
STATE CORPORATION COMMISSION

WELL PLUGGING RECORD

Give All Information Completely
Make Required Affidavit
Mail or Deliver Report to
Conservation Division
State Corporation Comm.
245 North Water
Wichita, KS 67202

Ness County, Sec. 20 Twp. 17S Rge. 21 E/W
Location as "NE/CNW $\frac{1}{4}$ SW $\frac{1}{4}$ " or footage from lines
C NE SW

Lease Owner Longhorn Energy Resources, Inc.
Lease Name Brenner Well No. 1
Office Address P.O. Box 1314, Great Bend, Kansas 67530
Character of Well (Completed as Oil, Gas or Dry Hole)
Dry Hole

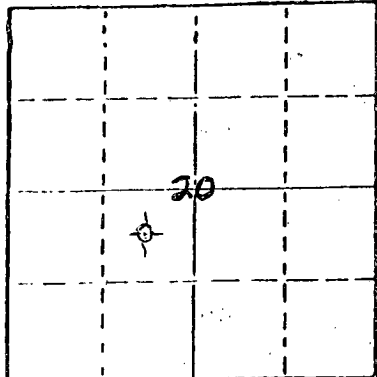

Locate well correctly on above
Section Plat

Date Well completed 7-14 19 82
Application for plugging filed 7-14 19 82
Application for plugging approved 7-14 19 82
Plugging commenced 7-14 19 82
Plugging completed 7-14 19 82
Reason for abandonment of well or producing formation

If a producing well is abandoned, date of last production
19

Was permission obtained from the Conservation Division or
its agents before plugging was commenced?

Name of Conservation Agent who supervised plugging of this well Steve Durant
Producing formation Depth to top Bottom Total Depth of Well
Show depth and thickness of all water, oil and gas formations. RTD 4350'

OIL, GAS OR WATER RECORDS

CASING RECORD

FORMATION	CONTENT	FROM	TO	SIZE	PUT IN	PULLED OUT
	Surface	0	408	8-5/8"	yes	no

Describe in detail the manner in which the well was plugged, indicating where the mud fluid
was placed and the method or methods used in introducing it into the hold. If cement or other
plugs were used, state the character of same and depth placed, from feet to
feet for each plug set.

- 70 sx. @ 900'
- 40 sx. @ 361'
- 10 sx. @ 40'
- 7 sx. in rathole
- Job complete @ 5:00 p.m. 7/14/82

(If additional description is necessary, use BACK of this sheet)

Name of Plugging Contractor Big-H Drilling, Inc.

STATE OF KANSAS COUNTY OF SEDGWICK, ss.
Wilber Berg, Big-H Drilling, Inc., (employee of owner) or (owner or operator)
of the above-described well, being first duly sworn on oath, says: That I have knowledge of
the facts, statements, and matters herein contained and the log of the above-described well
as filed and that the same are true and correct. So help me God.

(Signature) Wilber Berg
Wilber Berg
400 One Main Place, Wichita, Kansas 67202
(Address)

SUBSCRIBED AND SWORN TO before me this 14 day of July, 19 82

SANDRA L. MENDOZA
STATE NOTARY PUBLIC
SEDGWICK COUNTY, KANSAS
MY APPT. EXP.

My commission expires 2/12/86

Sandra L. Mendoza
Notary Public.

RECEIVED
STATE CORPORATION COMMISSION
02-06-1984
FEB 06 1984

CONSERVATION DIVISION
Wichita, Kansas