

CARD MUST BE TYPED

State of Kansas

CARD MUST BE SIGNED ✓

NOTICE OF INTENTION TO DRILL

(see rules on reverse side)

Starting Date 9 - 11 - 87
month day year

API Number 15-101-21, 418-00-00

OPERATOR: License # 5063
Name Energy Exploration, Inc.
Address 1002 S. Broadway
City/State/Zip Wichita, Kansas 67211
Contact Person Brad Lehl
Phone 316-267-7336

NW. SE. SE. Sec. 21 Twp. 16 S, Rg. 29 East
_____ West
990' Ft. from South Line of Section
990' Ft. from East Line of Section

(Note: Locate well on Section Plat on reverse side)

CONTRACTOR: License # 5107
Name H-30 Drilling, Inc.
City/State Wichita, Kansas

Nearest lease or unit boundary line 990' feet
County Lane
Lease Name Pam Well # 1

Well Drilled For: Well Class: Type Equipment:
 Oil SWD Infield Mud Rotary
 Gas Inj Pool Ext. Air Rotary
 OWWO Expl Wildcat Cable

Ground surface elevation 2805 feet MSL
Domestic well within 330 feet: yes no
Municipal well within one mile: yes no

If OWWO: old well info as follows:

Depth to bottom of fresh water 1400'
Depth to bottom of usable water 200'
Surface pipe by Alternate: 1 2

Operator _____
Well Name _____
Comp Date _____ Old Total Depth _____

Surface pipe planned to be set 260'
Conductor pipe required _____
Projected Total Depth 4550 feet
Formation Mississippian

I certify that well will comply with K.S.A. 55-101, et seq., plus eventually plugging hole to KCC specifications.

Date 9/9/87 Signature of Operator or Agent [Signature] Title President

For KCC Use:

Conductor Pipe Required _____ feet; Minimum Surface Pipe Required 200 feet per Alt. XO 2

This Authorization Expires 3-9-88 Approved By [Signature] 9-9-87


Effective 9-14-87

Must be filed with the K.C.C. five (5) days prior to commencing well
This card void if drilling not started within six (6) months of date received by K.C.C.

Important procedures to follow:

1. Notify District office before setting surface casing.
2. Set surface casing by circulating cement to the top.
3. File completion forms ACO-1 with K.C.C. within 90 days of well completion, following instructions on ACO-1, side 1, and including copies of wireline logs.
4. Notify District office 48 hours prior to old well workover or re-entry.
5. Prior to filing Intent, prepare a proposed plugging plan in case well is D & A, then obtain approval of plan when calling district office prior to setting surface pipe.
6. Submit plugging report (CP-4) to K.C.C. after plugging is completed.
7. Obtain an approved injection docket number before disposing of salt water.
8. Notify K.C.C. within 10 days when injection commences or terminates.
9. If an alternate 2 completion, cement in the production pipe from below any usable water to surface within 120 days of spud date.

A Regular Section of Land 1 Mile = 5,280 Ft.

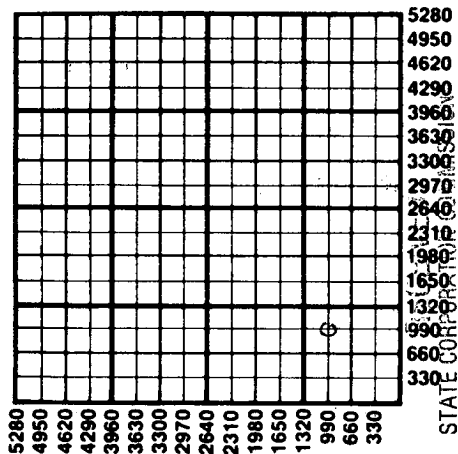

SEP 9 1987

CONSERVATION DIVISION
Wichita, Kansas

09-09-1987

State Corporation Commission of Kansas
Conservation Division
200 Colorado Derby Building
Wichita, Kansas 67202
(316) 263-3238