

CARD MUST BE TYPED

State of Kansas
NOTICE OF INTENTION TO DRILL
(see rules on reverse side)

CARD MUST BE SIGNED

Starting Date: ... August 20, 1985 ...
month day year

API Number 15- 101-21,208-00-00

OPERATOR: License # 5144
Name Mull Drilling Company, Inc.
Address P.O. Box 2758
City/State/Zip Wichita, Kansas 67201
Contact Person Patricia Ungleich
Phone 264-6366

NE. SE. SW Sec 25. Twp 16S. S, Rge 29W East West
(location)

990' Ft North from Southeast Corner of Section
2970' Ft West from Southeast Corner of Section
(Note: Locate well on Section Plat on reverse side)

CONTRACTOR: License # 5476
Name DNB DRILLING, INC.
City/State 535 N. Oliver, Wichita, KS

Nearest lease or unit boundary line 330' feet.
County Lane

Lease Name EATON Well# #1
67208
Domestic well within 330 feet: yes no

Well Drilled For: Well Class: Type Equipment:
 Oil Swd Infield Mud Rotary
 Gas Inj Pool Ext. Air Rotary
 OWWO Expl Wildcat Cable

Municipal well within one mile: yes no

If OWWO: old well info as follows:

Operator
Well Name
Comp Date Old Total Depth
Projected Total Depth 4630' feet
Projected Formation at TD Mississippian
Expected Producing Formations Lansing-Marmaton

Depth to Bottom of fresh water 150 feet
Lowest usable water formation Dakota
Depth to Bottom of usable water 1100' feet
Surface pipe by Alternate: 1 2XX *See below
Surface pipe to be set 8-5/8" @ 350' ± feet
Conductor pipe if any required feet
Ground surface elevation feet MSL
This Authorization Expires 2-6-86
Approved By 8-6-85 R

I certify that we will comply with K.S.A. 55-101, et seq., plus eventually plugging hole to K.C.C. specifications.

Date 8/05/85 Signature of Operator or Agent

Paul M. Gunzelman
Paul M. Gunzelman Title


*Csg will be cemented immediately from Geologist below usable water

RCH FORKHE

RECEIVED
STATE CORPORATION COMMISSION

Must be filed with the K.C.C. five (5) days prior to commencing well
This card void if drilling not started within six (6) months of date received by K.C.C.

AUG 6 1985
08-06-1985
CONSERVATION DIVISION
A Regular Section of Land
1 Mile = 5,280 Ft.

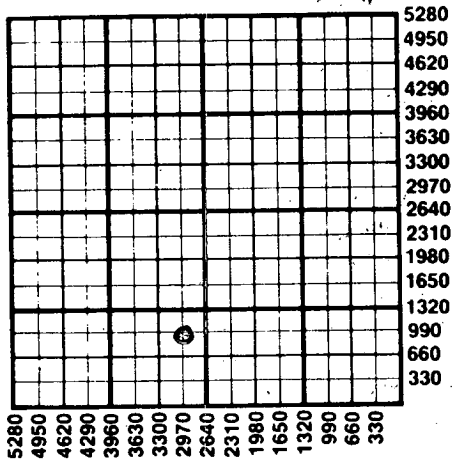

Important procedures to follow:

1. Notify District office before setting surface casing.
2. Set surface casing by circulating cement to the top.
3. File completion forms ACO-1 with K.C.C. within 90 days of well completion, following instructions on ACO-1, side 1, and including copies of wireline logs.
4. Notify District office 48 hours prior to old well workover or re-entry.
5. Prior to plugging, prepare a plugging plan, then obtain agreement from the appropriate district office for an approved plugging plan.
6. Submit plugging report (CP-4) to K.C.C. after plugging is completed.
7. Obtain an approved injection docket number before disposing of salt water.
8. Notify K.C.C. within 10 days when injection commences or terminates.
9. If an alternate 2 completion, cement in the production pipe from below any usable water to surface within 120 days of spud date.

State Corporation Commission of Kansas
Conservation Division
200 Colorado Derby Building
Wichita, Kansas 67202
(316) 263-3238