

CARD MUST BE TYPED

State of Kansas
NOTICE OF INTENTION TO DRILL
 (see rules on reverse side)

CARD MUST BE SIGNED

Starting Date: November 12 1984
 month day year

OPERATOR: License # 5238
 Name Petroleum, Inc.
 Address 300 W. Douglas, Suite 800
 City/State/Zip Wichita, KS 67202
 Contact Person Monte Chadd
 Phone (316) 793-8471

CONTRACTOR: License # 5476
 Name DNB Drilling, Inc.
 City/State 535 N. Oliver, Wichita, KS 67208


Well Drilled For:	Well Class:	Type Equipment:
☒ Oil ☐ Swd ☐ Infield ☐ Mud Rotary		
☐ Gas ☐ Inj ☐ Pool Ext. ☐ Air Rotary		
☐ OWWO ☐ Expl ☒ Wildcat ☐ Cable		

If OWWO: old well info as follows:

Operator
 Well Name
 Comp Date Old Total Depth
 Projected Total Depth feet
 Projected Formation at TD Mississippi
 Expected Producing Formations

I certify that we will comply with K.S.A. 55-101, et seq., plus eventually plugging hole to K.C.C. specifications.

Date 11-5-84 Signature of Operator or Agent

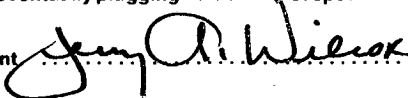

Title District Landman

API Number 15- 101-21,079-00-00

NW SE NE Sec 24 Twp 17 S, Rge 30
 (location) ☐ East ☒ West

3500 Ft North from Southeast Corner of Section
 1060 Ft West from Southeast Corner of Section
 Note: Locate well on Section Plat on reverse side)


Nearest lease or unit boundary line 860 feet.
 County Lane
 Lease Name Burmeister 'D' Well# 1
 Domestic well within 330 feet: ☐ yes ☒ no
 Municipal well within one mile: ☐ yes ☒ no

Depth to Bottom of fresh water 150 feet
 Lowest usable water formation Dakota
 Depth to Bottom of usable water 1200 feet
 Surface pipe by Alternate: 1 ☐ 2 ☒
 Surface pipe to be set 250 feet
 Conductor pipe if any required -- feet
 Ground surface elevation feet MSL
 This Authorization Expires 5-5-85
 Approved By 11-5-84 R

mhc/KOHE 11/5/84
 Form C-1 4/84

Must be filed with the K.C.C. five (5) days prior to commencing well
This card void if drilling not started within six (6) months of date received by K.C.C.

A Regular Section of Land
1 Mile = 5,280 Ft.

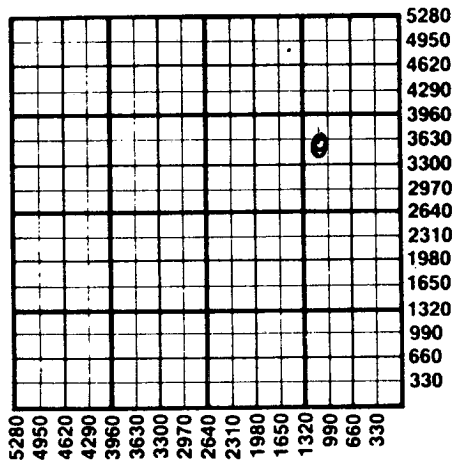

Important procedures to follow:

1. Notify District office before setting surface casing.
2. Set surface casing by circulating cement to the top.
3. File completion forms ACO-1 with K.C.C. within 90 days of well completion, following instructions on ACO-1, side 1, and including copies of wireline logs.
4. Notify District office 48 hours prior to old well workover or re-entry.
5. Prior to plugging, prepare a plugging plan, then obtain agreement from the appropriate district office for an approved plugging plan.
6. Submit plugging report (CP-4) to K.C.C. after plugging is completed.
7. Obtain an approved injection docket number before disposing of salt water.
8. Notify K.C.C. within 10 days when injection commences or terminates.
9. If an alternate 2 completion, cement in the production pipe from below any usable water to surface within 120 days of spud date.

State Corporation Commission of Kansas
Conservation Division
200 Colorado Derby Building
Wichita, Kansas 67202
(316) 263-3238

NOV 05 1984

RECEIVED
STATE CORPORATION COMMISSION