

CARD MUST BE TYPED

State of Kansas  
NOTICE OF INTENTION TO DRILL  
(see rules on reverse side)

CARD MUST BE SIGNED

Starting Date: 10/21/85 November 2 1985  
month day year

OPERATOR: License # 5399  
Name American Energies Corporation  
Address 575 Fourth Financial Center  
City/State/Zip Wichita, KS 67202  
Contact Person Alan L. DeGood  
Phone 316-263-5785

CONTRACTOR: License # 5149  
Name Wheatstate Oilfield Services Inc.  
City/State Pratt, Kansas

Well Drilled For: Well Class: Type Equipment:  
 Oil  Swd  Infield  Mud Rotary  
 Gas  Inj  Pool Ext.  Air Rotary  
 OWWO  Expl  Wildcat  Cable

If OWWO: old well info as follows:

Operator .....  
Well Name .....  
Comp Date ..... Old Total Depth .....

Projected Total Depth 4500 feet

Projected Formation at TD Mississippian

Expected Producing Formations Lansing-Kansas City

I certify that we will comply with K.S.A. 55-101, et seq., plus eventually plugging hole to K.C.C. specifications.

Date 10/21/85 Signature of Operator or Agent

Alan L. DeGood

Title

Vice President

API Number 15- 101-21-242-00-00

East  
. NW . SE . NW . . . Sec 8 . . Twp 16 . S, Rge 29 . .  West  
(location)

3630 . . . Ft North from Southeast Corner of Section  
3630 . . . Ft West from Southeast Corner of Section  
(Note: Locate well on Section Plat on reverse side)

Nearest lease or unit boundary line 990 feet.  
County Lane

Lease Name Jennison "B" 1  
Well #

Domestic well within 330 feet:  yes  no

Municipal well within one mile:  yes  no

Depth to Bottom of fresh water 300 feet

Lowest usable water formation Dakota

Depth to Bottom of usable water 1100 feet

Surface pipe by Alternate: 1  2

Surface pipe to be set 350 feet

Conductor pipe if any required N/A feet

Ground surface elevation N/A feet MSL


This Authorization Expires 4-22-86

Approved By 10-22-85

RCH/KDHE

**Must be filed with the K.C.C. five (5) days prior to commencing well  
This card void if drilling not started within six (6) months of date received by K.C.C.**

**A Regular Section of Land  
1 Mile = 5,280 Ft.**

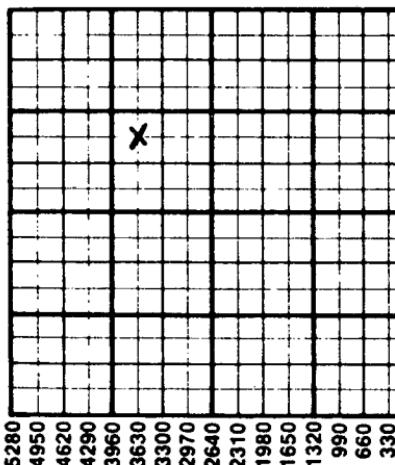

**Important procedures to follow :**

1. Notify District office before setting surface casing.
2. Set surface casing by circulating cement to the top.
3. File completion forms ACO-1 with K.C.C. within 90 days of well completion, following instructions on ACO-1, side 1, and including copies of wireline logs.
4. Notify District office 48 hours prior to old well workover or re-entry.
5. Prior to plugging, prepare a plugging plan, then obtain agreement from the appropriate district office for an approved plugging plan.
6. Submit plugging report (CP-4) to K.C.C. after plugging is completed.
7. Obtain an approved injection docket number before disposing of salt water.
8. Notify K.C.C. within 10 days when injection commences or terminates.

**RECEIVED** If an alternate 2 completion, cement in the production pipe from below any usable water to surface within 120 days of spud date.  
STATE CORPORATION COMMISSION

**OCT 22 1985  
10-22-1985  
CONSERVATION DIVISION  
Wichita, Kansas**

**State Corporation Commission of Kansas  
Conservation Division  
200 Colorado Derby Building  
Wichita, Kansas 67202  
(316) 263-3238**