

CARD MUST BE TYPED

State of Kansas
NOTICE OF INTENTION TO DRILL
(see rules on reverse side)

CARD MUST BE SIGNED

Starting Date: 5 18 85
month day year

API Number 15- 101-21, 170-00-00

OPERATOR: License # 5151

. NW . SE . NE Sec .30. Twp .16. S, Rge .29 East
(location) West

Name Gear Petroleum Co., Inc.

Address 300 Sutton Place

City/State/Zip Wichita, KS 67202

Contact Person Jim Thatcher

Phone 316-265-3351

..... 3630 Ft North from Southeast Corner of Section
..... 990 Ft West from Southeast Corner of Section
(Note: Locate well on Section Plat on reverse side)

CONTRACTOR: License # 5302

Name Red Tiger Drilling Co.

City/State Wichita, KS 67202

Nearest lease or unit boundary line 330 feet.

County Lane

Lease Name Yvonne Well# 1-30.

Domestic well within 330 feet : yes no

Municipal well within one mile : yes no

Well Drilled For: Well Class: Type Equipment:

- Oil Swd Infield Mud Rotary
- Gas Inj Pool Ext. Air Rotary
- OWWO Expl Wildcat Cable

Depth to Bottom of fresh water 200 feet

Lowest usable water formation Dakota

Depth to Bottom of usable water 1100 feet

Surface pipe by Alternate : 1 2 **

Surface pipe to be set 320 feet

Conductor pipe if any required --- feet

Ground surface elevation unknown feet MSL.

This Authorization Expires 11-7-85

If OWWO: old well info as follows:

Operator

Well Name

Comp Date Old Total Depth

Projected Total Depth 4600 feet

Projected Formation at TD Mississippian

Expected Producing Formations LKC, Cherokee

Approved By 5-7-85 *[Signature]*

I certify that we will comply with K.S.A. 55-101, et seq., plus eventually plugging hole to K.C.C. specifications.

** Stage collar @ 1100, will cement to surface**

Date 5-7-85 Signature of Operator or Agent *[Signature]* Title

Production Engineer *[Signature]*

Must be filed with the K.C.C. five (5) days prior to commencing well
This card void if drilling not started within six (6) months of date received by K.C.C.


RECEIVED
STATE CORPORATION COMMISSION
05-07-1985
MAY 7 1985

Important procedures to follow:

A Regular Section of Land
1 Mile = 5,280 Ft.

Wichita, Kansas

1. Notify District office before setting surface casing.
2. Set surface casing by circulating cement to the top.
3. File completion forms ACO-1 with K.C.C. within 90 days of well completion, following instructions on ACO-1, side 1, and including copies of wireline logs.
4. Notify District office 48 hours prior to old well workover or re-entry.
5. Prior to plugging, prepare a plugging plan, then obtain agreement from the appropriate district office for an approved plugging plan.
6. Submit plugging report (CP-4) to K.C.C. after plugging is completed.
7. Obtain an approved injection docket number before disposing of salt water.
8. Notify K.C.C. within 10 days when injection commences or terminates.
9. If an alternate 2 completion, cement in the production pipe from below any usable water to surface within 120 days of spud date.

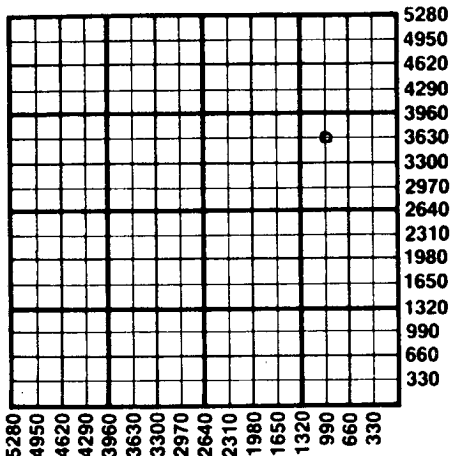

State Corporation Commission of Kansas
Conservation Division
200 Colorado Derby Building
Wichita, Kansas 67202
(316) 263-3238