

CARD MUST BE TYPED

State of Kansas  
NOTICE OF INTENTION TO DRILL

CARD MUST BE SIGNED

(see rules on reverse side)

Starting Date: ..... 10 25 1984  
month day year

API Number 15- 101-21,068-00-00

OPERATOR: License # ..... 6113  
Name ..... Landmark Oil Exploration, Inc.  
Address ..... 105 S. Broadway, Suite 1040  
City/State/Zip ..... Wichita, Kansas 67202  
Contact Person ..... Mel Hussey  
Phone ..... (316) 265-8181

Ctr. NW. NW. NE Sec 19. Twp 16. S, Rge .. 29  East  
(location)  West

4950 ..... Ft North from Southeast Corner of Section  
2310 ..... Ft West from Southeast Corner of Section  
(Note: Locate well on Section Plat on reverse side)

CONTRACTOR: License # ..... 5420  
Name ..... White & Ellis Drilling, Inc.  
City/State ..... Wichita, Kansas 67202

Nearest lease or unit boundary line ..... 330 ..... feet.  
County ..... Lane  
Lease Name ..... Magie ..... Well# 1-19  
Domestic well within 330 feet :  yes  no  
Municipal well within one mile :  yes  no

Well Drilled For: Well Class: Type Equipment:  
 Oil  Swd  Infield  Mud Rotary  
 Gas  Inj  Pool Ext.  Air Rotary  
 OWWO  Expl  Wildcat  Cable

Depth to Bottom of fresh water ..... 200 ..... feet  
Lowest usable water formation ..... Dakota .....  
Depth to Bottom of usable water ..... 1100 ..... feet  
Surface pipe by Alternate : 1  2   
Surface pipe to be set ..... 275 ..... feet  
Conductor pipe if any required ..... None ..... feet  
Ground surface elevation ..... feet MSL  
This Authorization Expires 4/17/85  
Approved By *RCH/KCC* 10/17/84

If OWWO: old well info as follows:

Operator .....  
Well Name .....  
Comp Date ..... Old Total Depth .....  
Projected Total Depth ..... 4500 ..... feet  
Projected Formation at TD ..... Mississippi  
Expected Producing Formations ..... Marmaton

I certify that we will comply with K.S.A. 55-101, et seq., plus eventually plugging hole to K.C.C. specifications.

Date ..... 10-17-84  
Signature of Operator or Agent

*Mel C. Hussey*  
Merlin C. Hussey Title Exploration Manager

Form C-1 4/84

*MHC/WOHE 10/17/84*

Must be filed with the K.C.C. five (5) days prior to commencing well  
This card void if drilling not started within six (6) months of date received by K.C.C.


CONSERVATION DIVISION  
WICHITA, KANSAS

OCT 17 1984  
48871100  
10-17-1984

**Important procedures to follow :**

STATE CORPORATION COMMISSION  
A Regular Section of Land  
1 Mile 5-280-5280  
RECEIVED

1. Notify District office before setting surface casing.
2. Set surface casing by circulating cement to the top.
3. File completion forms ACO-1 with K.C.C. within 90 days of well completion, following instructions on ACO-1, side 1, and including copies of wireline logs.
4. Notify District office 48 hours prior to old well workover or re-entry.
5. Prior to plugging, prepare a plugging plan, then obtain agreement from the appropriate district office for an approved plugging plan.
6. Submit plugging report (CP-4) to K.C.C. after plugging is completed.
7. Obtain an approved injection docket number before disposing of salt water.
8. Notify K.C.C. within 10 days when injection commences or terminates.
9. If an alternate 2 completion, cement in the production pipe from below any usable water to surface within 120 days of spud date.

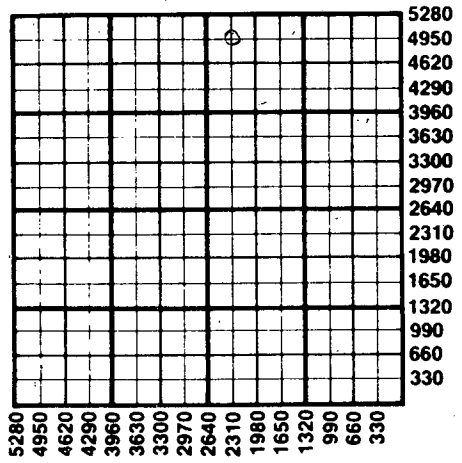

State Corporation Commission of Kansas  
Conservation Division  
200 Colorado Derby Building  
Wichita, Kansas 67202  
(316) 263-3238