

CARD MUST BE TYPED

State of Kansas
NOTICE OF INTENTION TO DRILL
(see rules on reverse side)

CARD MUST BE SIGNED

Starting Date: September 27 1985
month day year

API Number is- 101-21,231-00-00

OPERATOR: License # KCC #9816
Name Fagin Exploration Company
Address 1801 California St., Ste. 4380
City/State/Zip Denver, Colorado 80202
Contact Person Mr. David Fagin
Phone 303-293-2703

Approx. NW SW Sec 29 Twp 18 S, Rge 28 East
(location) West

2192
4738 Ft North from Southeast Corner of Section
Ft West from Southeast Corner of Section
(Note: Locate well on Section Plat on reverse side)

CONTRACTOR: License # 6033
Name Murfin Drilling Company
City/State Wichita, Kansas 67202

Nearest lease or unit boundary line 448 feet.
County Lane
Lease Name Hineman Well# 1-29

Well Drilled For: Well Class: Type Equipment:
 Oil Swd Infield Mud Rotary
 Gas Inj Pool Ext. Air Rotary
 OWWO Expl Wildcat Cable

Domestic well within 330 feet: yes no
Municipal well within one mile: yes no

If OWWO: old well info as follows:
Operator _____
Well Name _____
Comp Date _____ Old Total Depth _____
Projected Total Depth 4700 feet
Projected Formation at TD Miss.
Expected Producing Formations LKC-Miss.

Depth to Bottom of fresh water 150 feet
Lowest usable water formation Dakota
Depth to Bottom of usable water 1075 feet
Surface pipe by Alternate: 1 2
Surface pipe to be set 300 feet
Conductor pipe if any required N/A feet
Ground surface elevation 2713 feet MSL
This Authorization Expires 3-20-86
Approved By 9-20-85

I certify that we will comply with K.S.A. 55-101, et seq., plus eventually plugging hole to K.G.C. specifications.


Date 9/20/85 Signature of Operator or Agent

David K. Fagin Title President
RCA/KDHE

**Must be filed with the K.C.C. five (5) days prior to commencing well
This card void if drilling not started within six (6) months of date received by K.C.C.**

Important procedures to follow :

**A Regular Section of Land
1 Mile = 5,280 Ft.**

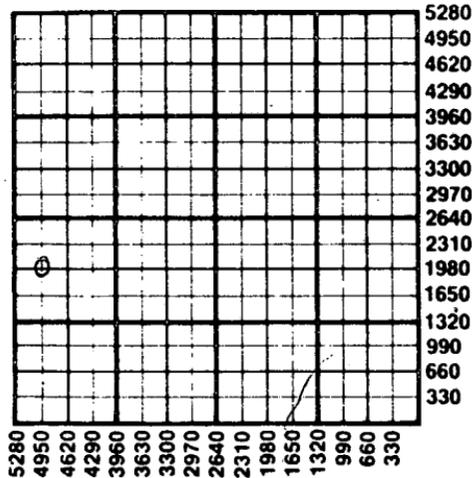

1. Notify District office before setting surface casing.
2. Set surface casing by circulating cement to the top.
3. File completion forms ACO-1 with K.C.C. within 90 days of well completion, following instructions on ACO-1, side 1, and including copies of wireline logs.
4. Notify District office 48 hours prior to old well workover or re-entry.
5. Prior to plugging, prepare a plugging plan, then obtain agreement from the appropriate district office for an approved plugging plan.
6. Submit plugging report (CP-4) to K.C.C. after plugging is completed.
7. Obtain an approved injection docket number before disposing of salt water.
8. Notify K.C.C. within 10 days when injection commences or terminates.
9. If an alternate 2 completion, cement in the production pipe from below any usable water to surface within 120 days of spud date.

State Corporation Commission of Kansas
Conservation Division

200 Colorado Derby Building
Wichita, Kansas 67202
(316) 263-3238

RECEIVED
STATE CORPORATION COMMISSION

SEP 20 1985

CONSERVATION DIVISION
Wichita, Kansas