

CARD MUST BE TYPED

State of Kansas

CARD MUST BE SIGNED

NOTICE OF INTENTION TO DRILL

(see rules on reverse side)

Starting Date September 16 1986
month day year 2:57

API Number 15— 101-21,334-00-00 — East

OPERATOR: License # 5181
 Name SLAWSON, DONALD C.
 Address 200 Douglas Building
 City/State/Zip .. Wichita, Kansas 67202
 Contact Person. Bill Horgan
 Phone (316) 263-3201

NE. NE. NE. Sec. 27... Twp. 18. S, Rg. 28... X West
 4950' Ft. from South Line of Section
 330' Ft. from East Line of Section

(Note: Locate well on Section Plat on reverse side)

CONTRACTOR: License # 5657
 Name Slawson Drlg. Co.
 City/State Wichita, Kansas

Nearest lease or unit boundary line 330' feet
 County Lane

Lease Name RICHARDS 'S' Well # 1
 Ground surface elevation 2730' (Seis) feet MSL

Well Drilled For: Well Class: Type Equipment:
☒ Oil ☐ SWD ☐ Infield ☒ Mud Rotary
☐ Gas ☐ Inj ☐ Pool Ext. ☐ Air Rotary
☐ OWWO ☐ Expl ☒ Wildcat ☐ Cable

Domestic well within 330 feet: ☐ yes ☐ no
 Municipal well within one mile: ☐ yes ☐ no

Depth to bottom of fresh water 180'

Depth to bottom of usable water ~~1000'~~ / 200'

Surface pipe by Alternate: 1 ☐ 2 ☒ X

Surface pipe planned to be set 240'

Conductor pipe required

Projected Total Depth 4650' feet

Formation Mississippian

If OWWO: old well info as follows:

Operator

Well Name

Comp Date Old Total Depth

I certify that well will comply with K.S.A. 55-101, et seq., plus eventually plugging hole to KCC specifications. Western Kansas

Date ... 9/15/86 Signature of Operator or Agent Robert B. Jenkins Title District Geologist

For KCC Use:

Conductor Pipe Required feet; Minimum Surface Pipe Required feet per Alt. 20

This Authorization Expires 3-16-87 Approved By 9-16-86


fch/KCC

Must be filed with the K.C.C. five (5) days prior to commencing well
This card void if drilling not started within six (6) months of date received by K.C.C.

Important procedures to follow:

1. Notify District office before setting surface casing.
2. Set surface casing by circulating cement to the top.
3. File completion forms ACO-1 with K.C.C. within 90 days of well completion, following instructions on ACO-1, side 1, and including copies of wireline logs.
4. Notify District office 48 hours prior to old well workover or re-entry.
5. Prior to filing Intent, prepare a proposed plugging plan in case well is D & A, then obtain approval of plan when calling district office prior to setting surface pipe.
6. Submit plugging report (CP-4) to K.C.C. after plugging is completed.
7. Obtain an approved injection docket number before disposing of salt water.
8. Notify K.C.C. within 10 days when injection commences or terminates.

A Regular Section of Land 1 Mile = 5,280 Ft.

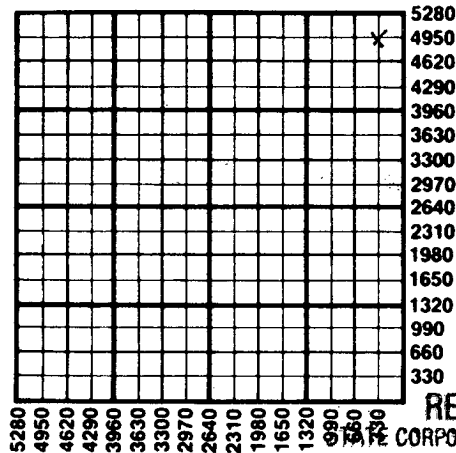

RECEIVED

STATE CORPORATION COMMISSION

SEP 16 1986

CONSERVATION DIVISION
Wichita, Kansas

If an alternate 2 completion, cement in the production pipe from below any usable water to surface within 120 days of spud date.

State Corporation Commission of Kansas
Conservation Division
200 Colorado Derby Building
Wichita, Kansas 67202
(316) 263-3238