

NOTICE OF INTENTION TO DRILL

(see rules on reverse side)

Starting Date 12 16 85 month day year

API Number 15- 101-21,264-00-00

OPERATOR: License # 5161 Name Palomino Petroleum Address P.O. Box 18610 City/State/Zip Wichita, KS 67218 Contact Person Bob Watchous Phone (316) 683-8152

SW. NE. SE. Sec. 21 Twp. 19 S, Rg. 28 West 1650 Ft. from South Line of Section 990 Ft. from East Line of Section

(Note: Locate well on Section Plat on reverse side)

CONTRACTOR: License # 5476 Name DNB Drilling, Inc. City/State Wichita, KS

Nearest lease or unit boundary line 990 feet County Lane

Well Drilled For: Well Class: Type Equipment: X Oil SWD Infield X Mud Rotary Gas Inj Pool Ext. Air Rotary OWWO Expl X Wildcat Cable

Lease Name Mowery Trust Well # 1 Ground surface elevation 2780 est feet MSL

If OWWO: old well info as follows:

Domestic well within 330 feet: yes X no Municipal well within one mile: yes X no Surface pipe by Alternate: 1 2 X Depth to bottom of fresh water 100 Depth to bottom of usable water 1050 Surface pipe planned to be set 240+ Projected Total Depth 4700 feet Formation Miss.

Operator Well Name Comp Date Old Total Depth

I certify that well will comply with K.S.A. 55-101, et seq., plus eventually plugging hole to KCC specifications.

X cementing will be done immediately upon setting production casing Date 12-2-85 Signature of Operator or Agent Bob Watchous Title Owner

For KCC Use:


Conductor Pipe Required feet; Minimum Surface Pipe Required feet per Alt. 2 This Authorization Expires 6-3-86 Approved By 12-3-85

Must be filed with the K.C.C. five (5) days prior to commencing well
This card void if drilling not started within six (6) months of date received by K.C.C.

Important procedures to follow:

1. Notify District office before setting surface casing.
2. Set surface casing by circulating cement to the top.
3. File completion forms ACO-1 with K.C.C. within 90 days of well completion, following instructions on ACO-1, side 1, and including copies of wireline logs.
4. Notify District office 48 hours prior to old well workover or re-entry.
5. Prior to filing Intent, prepare a proposed plugging plan in case well is D & A, then obtain approval of plan when calling district office prior to setting surface pipe.
6. Submit plugging report (CP-4) to K.C.C. after plugging is completed.
7. Obtain an approved injection docket number before disposing of salt water.
8. Notify K.C.C. within 10 days when injection commences or terminates.
9. If an alternate 2 completion, cement in the production pipe from how any usable water to surface within 120 days of spud date.

A Regular Section of Land
1 Mile = 5,280 Ft.

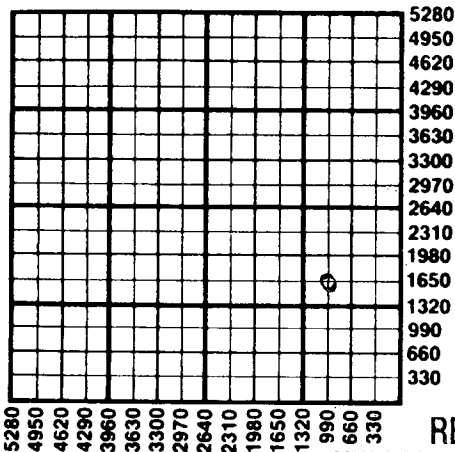

RECEIVED
STATE CORPORATION COMMISSION

DEC 3 1985
12-03-1985
CONSERVATION DIVISION
Wichita, Kansas

State Corporation Commission of Kansas
Conservation Division
200 Colorado Derby Building
Wichita, Kansas 67202
(316) 263-3238