

NOTICE OF INTENTION TO DRILL

(see rules on reverse side)

Starting Date Jan 31, 1986 month day year

API Number 15- 101-21,283-00-00

OPERATOR: License # 9746
Name Wilkar Oil Company
Address Box 3225, 10707 Norwalk Blvd.
City/State/Zip Santa Fe Springs, CA 90670
Contact Person Doc Hathaway
Phone 1-213-944-6703

Approx. SW NE NW Sec. 19 Twp. 19 S, Rg. 28
4270 Ft. from South Line of Section
3500 Ft. from East Line of Section

(Note: Locate well on Section Plat on reverse side)

CONTRACTOR: License # 5783
Name Galloway Drilling Co., Inc.
City/State Wichita, KS

Nearest lease or unit boundary line 860 feet
County Lane
Lease Name H. J. Hireman Cattle well Co. #1

Well Drilled For: Well Class: Type Equipment:
X Oil SWD Infield Mud Rotary
Gas Inj Pool Ext Air Rotary
OWWO Expl Wildcat Cable

Ground surface elevation 2796 feet MSL
Domestic well within 330 feet: yes X no
Municipal well within one mile: yes X no
Surface pipe by Alternate: 1 2X
Depth to bottom of fresh water 100
Depth to bottom of usable water 1050
Surface pipe planned to be set 240'
Projected Total Depth 4665 feet
Formation Mississippian

If OWWO: old well info as follows:

Operator
Well Name
Comp Date Old Total Depth

I certify that well will comply with K.S.A. 55-101, et seq., plus eventually plugging hole to KCC specifications.

Date 1/29/86 Signature of Operator or Agent

Title agent Ret/KOHE

For KCC Use:

Conductor Pipe Required feet; Minimum Surface Pipe Required 240 feet per Alt.


This Authorization Expires 2-29-86 Approved By 1-29-86

Must be filed with the K.C.C. five (5) days prior to commencing well  
This card void if drilling not started within six (6) months of date received by K.C.C.

**Important procedures to follow:**

1. Notify District office before setting surface casing.
2. Notify District office 48 hours prior to old well workover or re-entry.
3. File completion forms ACO-1 with K.C.C. within 90 days of well completion, following instructions on ACO-1, side 1, and including copies of wireline logs.
4. Notify District office 48 hours prior to old well workover or re-entry.
5. Prior to filing Intent, prepare a proposed plugging plan in case well is D & A, then obtain approval of plan when calling district office prior to setting surface pipe.
6. Submit plugging report (CP-4) to K.C.C. after plugging is completed.
7. Obtain an approved injection docket number before disposing of salt water.
8. Notify K.C.C. within 10 days when injection commences or terminates.
9. If an alternate 2 completion, cement in the production pipe from below any usable water to surface within 120 days of spud date.

**A Regular Section of Land**  
**1 Mile = 5,280 Ft.**

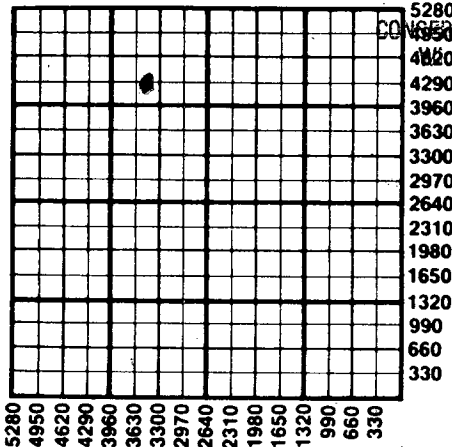

**RECEIVED**

STATE CORPORATION COMMISSION

01-29-1986  
JAN 29 1986

CONSERVATION DIVISION  
Wichita, Kansas

State Corporation Commission of Kansas  
Conservation Division  
200 Colorado Derby Building  
Wichita, Kansas 67202  
(316) 263-3238