

CARD MUST BE TYPED

State of Kansas

CARD MUST BE SIGNED

# NOTICE OF INTENTION TO DRILL

(see rules on reverse side)

*DA*

Expected Spud Date. 08/01/88  
month day year

API Number 15- 101-21,480-00-00

OPERATOR: License # 5020

NE $\frac{1}{4}$  NE $\frac{1}{4}$  NE $\frac{1}{4}$  Sec. 19 Twp. 19 S, Rg. 28 X East West

Name Rine Exploration Company

4950 Ft. from South Line of Section

Address Suite #645, 300 W. Douglas

330 Ft. from East Line of Section

City/State/Zip Wichita, KS 67202-2904

(Note: Locate well on Section Plat on reverse side)

Contact Person M. Bradford Rine

Nearest lease or unit boundary line 330 feet

Phone 316/262-5418

County Lane

CONTRACTOR: License # 5422

Lease Name Hineman "C" Well # 1-19

Name Abercrombie Drilling, Inc.

Ground surface elevation 2785 (L&S) feet MSL

City/State Wichita, KS 67202

Domestic well within 330 feet: yes X no

Well Drilled For: Well Class: Type Equipment:

Municipal well within one mile: yes X no

X Oil Storage Infield X Mud Rotary

Depth to bottom of fresh water. 200 100

X Gas Inj X Pool Ext. Air Rotary

Depth to bottom of usable water. 200 1300

OWWO Expl Wildcat Cable

Surface pipe by Alternate: 1 2 X

If OWWO: old well info as follows:

Surface pipe planned to be set 230

Operator

Conductor pipe required -0-

Well Name

Projected Total Depth 4700 feet

Comp Date Old Total Depth

Formation Mississippian

I certify that well will comply with K.S.A. 55-101, et seq., plus eventually plugging hole to KCC specifications.

Date 07/28/88 Signature of Operator or Agent W. D. Hess

Title Vice-President

For KCC Use:

Conductor Pipe Required 200' feet; Minimum Surface Pipe Required 200' feet per Alt. X (2)

This Authorization Expires 1-28-89 Approved By LKM 7-28-88


EFFECTIVE DATE: 8-2-88

Must be filed with the K.C.C. five (5) days prior to commencing well  
 This card void if drilling not started within six (6) months of date received by K.C.C.

**Important procedures to follow:**

1. Notify District office before setting surface casing.
  2. Set surface casing by circulating cement to the top.
  3. File completion forms ACO-1 with K.C.C. within 120 days of well spud date, following instructions on ACO-1, side 1, and including copies of wireline logs.
  4. Notify District office 48 hours prior to old well workover or re-entry.
  5. Prior to filing Intent, prepare a proposed plugging plan in case well is D & A, then obtain approval of plan when calling district office prior to setting surface pipe.
  6. Submit plugging report (CP-4) to K.C.C. after plugging is completed.
  7. Obtain an approved injection docket number before disposing of salt water.
- Notify K.C.C. within 10 days when injection commences or terminates.
9. If an alternate 2 completion, cement in the production pipe from below any usable water to surface within 120 days of spud date.

**A Regular Section of Land**  
**1 Mile = 5,280 Ft.**

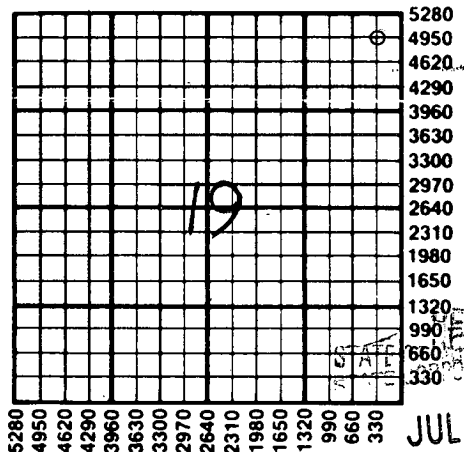

RECEIVED  
 CONSERVATION COMMISSION

JUL 28 1988

CONSERVATION DIVISION  
 Wichita, Kansas

07-28-1988

State Corporation Commission of Kansas  
 Conservation Division  
 200 Colorado Derby Building  
 Wichita, Kansas 67202-1212  
 (316) 263-3238