

CARD MUST BE TYPED

State of Kansas
NOTICE OF INTENTION TO DRILL
(see rules on reverse side)

CARD MUST BE SIGNED

Starting Date: 9 20 84
month day year

API Number 15- 135-22,676-00-00

OPERATOR: License # 5123
Name Pickrell Drilling Company
Address 110 N. Market, Suite 205
City/State/Zip Wichita, KS 67202
Contact Person Jay McNeil
Phone 262-8427

200' E S/2 SW NW Sec 15 Twp 16 S, Rge 21
(location) East West

CONTRACTOR: License # 5123
Name Pickrell Drilling Company
City/State Wichita, Kansas

2970 Ft North from Southeast Corner of Section
4420 Ft West from Southeast Corner of Section
(Note: Locate well on Section Plat on reverse side)

Well Drilled For: Well Class: Type Equipment:
 Oil Swd Infield Mud Rotary
 Gas Inj Pool Ext. Air Rotary
 OWWO Expl Wildcat Cable

Nearest lease or unit boundary line 330 .. feet.
County Ness
Lease Name Cline Well# 1-B
Domestic well within 330 feet: yes no
Municipal well within one mile: yes no

If OWWO: old well info as follows:

Operator
Well Name
Comp Date Old Total Depth
Projected Total Depth 4300 feet
Projected Formation at TD Mississippian
Expected Producing Formations Penn-Mississippian

Depth to Bottom of fresh water 60 feet
Lowest usable water formation Dakota
Depth to Bottom of usable water 900 feet
Surface pipe by Alternate: 1 2
Surface pipe to be set' 200+ feet
Conductor pipe if any required feet
Ground surface elevation 2304 feet MSL
This Authorization Expires 3-12-85
Approved By 9-12-84 *[Signature]*

I certify that we will comply with K.S.A. 55-101, et seq., plus eventually plugging hole to K.C.C. specifications.

Date 9-12-84 Signature of Operator or Agent

[Signature]

Title Jay McNeil-Chief Geologist


W H C / K R O H E 9 / 1 2 / 8 4

RECEIVED Must be filed with the K.C.C. five (5) days prior to commencing well
This card void if drilling not started within six (6) months of date received by K.C.C.
STATE CORPORATION COMMISSION

SEP 27 1984

09-12-1984

MULTIPLE WELL PERMIT
A Regular Section of Land
1 Mile = 5,280 Ft.
Wichita, Kansas

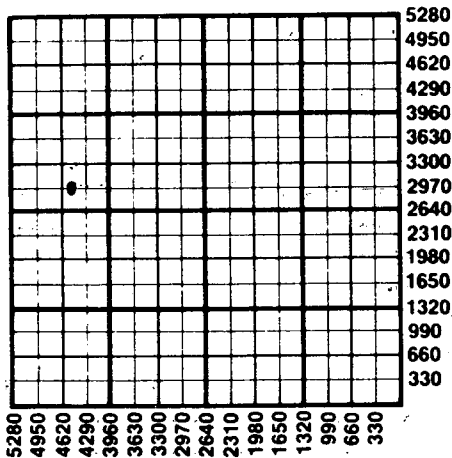

Important procedures to follow:

1. Notify District office before setting surface casing.
2. Set surface casing by circulating cement to the top.
3. File completion forms ACO-1 with K.C.C. within 90 days of well completion, following instructions on ACO-1, side 1, and including copies of wireline logs.
4. Notify District office 48 hours prior to old well workover or re-entry.
5. Prior to plugging, prepare a plugging plan, then obtain agreement from the appropriate district office for an approved plugging plan.
6. Submit plugging report (CP-4) to K.C.C. after plugging is completed.
7. Obtain an approved injection docket number before disposing of salt water.
8. Notify K.C.C. within 10 days when injection commences or terminates.
9. If an alternate 2 completion, cement in the production pipe from below any usable water to surface within 120 days of spud date.

State Corporation Commission of Kansas
Conservation Division
200 Colorado Derby Building
Wichita, Kansas 67202
(316) 263-3238