

CARD MUST BE TYPED

State of Kansas

CARD MUST BE SIGNED

# NOTICE OF INTENTION TO DRILL

(see rules on reverse side)

Starting Date ..... 7 ..... 7 ..... 88  
month day year

API Number 15- 135-23, 266-00-00 ✓  
150' North of \_\_\_\_\_ East  
N/2 SW/4 Sec. 15 Twp. 16 S, Rg. 21  West  
2130 \_\_\_\_\_ Ft. from South Line of Section  
3960 \_\_\_\_\_ Ft. from East Line of Section

OPERATOR: License # ..... 5146  
Name ..... Rains & Williamson Oil Co., Inc.  
Address ..... 220 West Douglas, Suite 435  
City/State/Zip ..... Wichita, Kansas 67202

(Note: Locate well on Section Plat on reverse side)  
Nearest lease or unit boundary line ..... ~~510~~ 510 feet  
County ..... Ness  
Lease Name ..... RYAN Well # ..... 2

Contact Person ..... Juanita Green  
Phone ..... (316) 265-9686

CONTRACTOR: License # ..... 5146  
Name ..... Same as Above  
City/State .....

Ground surface elevation ..... feet MSL  
Domestic well within 330 feet: \_\_\_\_\_ yes \_\_\_\_\_ no  
Municipal well within one mile: \_\_\_\_\_ yes \_\_\_\_\_ no  
Depth to bottom of fresh water ..... 80  
Depth to bottom of usable water ..... 625  
Surface pipe by Alternate: \_\_\_\_\_ 1 \_\_\_\_\_ 2  X  
Surface pipe planned to be set ..... 300  
Conductor pipe required ..... -0-  
Projected Total Depth ..... 4300 feet  
Formation ..... Cherokee Sand

Well Drilled For: Well Class: Type Equipment:  
 Oil \_\_\_\_\_ SWD \_\_\_\_\_ Infield  Mud Rotary  
 Gas \_\_\_\_\_ Inj  Pool Ext. \_\_\_\_\_ Air Rotary  
\_\_\_\_\_ OWWO \_\_\_\_\_ Expl \_\_\_\_\_ Wildcat \_\_\_\_\_ Cable

If OWWO: old well info as follows:  
Operator .....  
Well Name .....  
Comp Date ..... Old Total Depth .....

I certify that well will comply with K.S.A. 55-101, et seq., plus eventually plugging hole to KCC specifications.  
Date 6-28-88 Signature of Operator or Agent Wilson Rains Title PRESIDENT  
WILSON RAINS

For KCC Use:  
Conductor Pipe Required ..... feet; Minimum Surface Pipe Required ..... 200 feet per Alt. ✓ (2)  
This Authorization Expires 12-29-88 Approved By Pet. 6-29-88


EFFECTIVE DATE: 7-4-88

Must be filed with the K.C.C. five (5) days prior to commencing well  
This card void if drilling not started within six (6) months of date received by K.C.C.

**Important procedures to follow:**

1. Notify District office before setting surface casing.
2. Set surface casing by circulating cement to the top.
3. File completion forms ACO-1 with K.C.C. within 90 days of well completion, following instructions on ACO-1, side 1, and including copies of wireline logs.
4. Notify District office 48 hours prior to old well workover or re-entry.
5. Prior to filing Intent, prepare a proposed plugging plan in case well is D & A, then obtain approval of plan when calling district office prior to setting surface pipe.
6. Submit plugging report (CP-4) to K.C.C. after plugging is completed.
7. Obtain an approved injection docket number before disposing of salt water.
8. Notify K.C.C. within 10 days when injection commences or terminates.
9. If an alternate 2 completion, cement in the production pipe from below any usable water to surface within 120 days of spud date.

**A Regular Section of Land**  
**1 Mile = 5,280 Ft.**

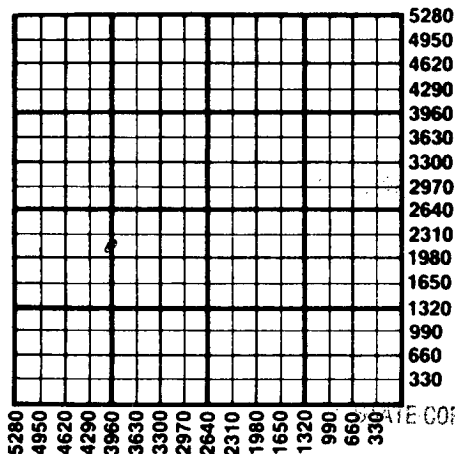

RECEIVED

STATE CORPORATION COMMISSION

JUN 20 1988  
06-20-1988  
CONSERVATION DIVISION  
Wichita, Kansas

State Corporation Commission of Kansas  
Conservation Division  
200 Colorado Derby Building  
Wichita, Kansas 67202  
(316) 263-3238