

NOTICE OF INTENTION TO DRILL

(see rules on reverse side)

Expected Spud Date... November 15, 1987
month day year

API Number 15- 135-23,187-00-00

✓
D-4

OPERATOR: License # 6484
Name Thornton E. Anderson
Address 212 N. Market, Suite 508
City/State/Zip Wichita, KS 67202
Contact Person William L. Anderson
Phone 265-7929

___ East
NW SW NE Sec. 14 Twp. 16 S, Rg. 21 ___ West
3630 Ft. from South Line of Section
2310 Ft. from East Line of Section

(Note: Locate well on Section Plat on reverse side)

Nearest lease or unit boundary line 330 feet
County Ness

CONTRACTOR: License # 5302
Name Red Tiger Drilling Company
City/State Wichita, KS 67202

Lease Name Ryan Well # 1

Ground surface elevation 2262 feet MSL

Domestic well within 330 feet: ___ yes X no

Municipal well within one mile: ___ yes X no

Well Drilled For: Well Class: Type Equipment:
X Oil ___ Storage ___ Infield X Mud Rotary
___ Gas ___ Inj X Pool Ext ___ Air Rotary
___ OWWO ___ Expl ___ Wildcat ___ Cable

Depth to bottom of fresh water 500'

Depth to bottom of usable water 650'

Surface pipe by Alternate: 1 ___ 2 X

Surface pipe planned to be set 250

Conductor pipe required NA

Projected Total Depth 4250 feet

Formation Mississippi

If OWWO: old well info as follows:

Operator
Well Name
Comp Date Old Total Depth

I certify that well will comply with K.S.A. 55-101, et seq., plus eventually plugging hole to KCC specifications:

Date 10/27/87 Signature of Operator or Agent William L. Anderson Title Operations Manager

For KCC Use:

Conductor Pipe Required ___ feet; Minimum Surface Pipe Required 200 feet per Alt. Y02

This Authorization Expires 5-5-88 Approved By P.H. 11-5-87


EFFECTIVE DATE: 11-10-87

Must be filed with the K.C.C. five (5) days prior to commencing well
This card void if drilling not started within six (6) months of date received by K.C.C.

Important procedures to follow:

1. Notify District office before setting surface casing.
2. Set surface casing by circulating cement to the top.
3. File completion forms ACO-1 with K.C.C. within 120 days of well spud date, following instructions on ACO-1, side 1, and including copies of wireline logs.
4. Notify District office 48 hours prior to old well workover or re-entry.
5. Prior to filing Intent, prepare a proposed plugging plan in case well is D & A, then obtain approval of plan when calling district office prior to setting surface pipe.
6. Submit plugging report (CP-4) to K.C.C. after plugging is completed.
7. Obtain an approved injection docket number before disposing of salt water.
8. Notify K.C.C. within 10 days when injection commences or terminates.
9. If an alternate 2 completion, cement in the production pipe from below any usable water to surface within 120 days of spud date.

A Regular Section of Land
1 Mile = 5,280 Ft.

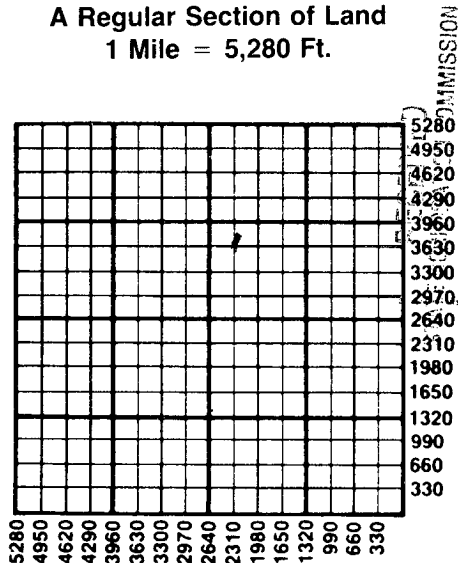

OCT 28 1987

CONSERVATION DIVISION
Wichita, Kansas

10-28-~~80~~
1987

State Corporation Commission of Kansas
Conservation Division
200 Colorado Derby Building
Wichita, Kansas 67202-1212
(316) 263-3238