

CARD MUST BE TYPED

State of Kansas

CARD MUST BE SIGNED

NOTICE OF INTENTION TO DRILL

(see rules on reverse side)

Expected Spud Date... 9/12/87
month day year

API Number 15-135-23,168 0000

OPERATOR: License # 6484
Name Thornton E. Anderson
Address 212 N. Market, Suite 508
City/State/Zip Wichita, KS 67202
Contact Person Bill Anderson
Phone 265-7929

NW NE NW Sec. 14 Twp. 16 S, Rg. 21
4950 Ft. from South Line of Section
3630 Ft. from East Line of Section

(Note: Locate well on Section Plat on reverse side)

CONTRACTOR: License # 5302
Name Red Tiger Drilling, Inc.
City/State Wichita, KS 67202

Nearest lease or unit boundary line 330 feet
County Ness
Lease Name Pugh Well # 2

Well Drilled For: Well Class: Type Equipment:
 Oil Storage Infield Mud Rotary
 Gas Inj Pool Ext. Air Rotary
 OWWO Expl Wildcat Cable

Ground surface elevation 2268' feet MSL
Domestic well within 330 feet: yes no
Municipal well within one mile: yes no

If OWWO: old well info as follows:

Depth to bottom of fresh water 500'
Depth to bottom of usable water 650'
Surface pipe by Alternate: 1 2

Operator
Well Name
Comp Date Old Total Depth

Surface pipe planned to be set 250'
Conductor pipe required
Projected Total Depth 4250' feet
Formation Mississippi

I certify that well will comply with K.S.A. 55-101, et seq., plus eventually plugging hole to KCC specifications.

Date 9/11/87 Signature of Operator or Agent William J. Anderson Operations Mgr.

For KCC Use:

Conductor Pipe Required feet; Minimum Surface Pipe Required 200 feet per Alt. 2


This Authorization Expires 3-11-88 Effective 9-16-87 Approved By #9-11-87

Must be filed with the K.C.C. five (5) days prior to commencing well
This card void if drilling not started within six (6) months of date received by K.C.C.

Important procedures to follow:

1. Notify District office before setting surface casing.
2. Set surface casing by circulating cement to the top.
3. File completion forms ACO-1 with K.C.C. within 120 days of well spud date, following instructions on ACO-1, side 1, and including copies of wireline logs.
4. Notify District office 48 hours prior to old well workover or re-entry.
5. Prior to filing Intent, prepare a proposed plugging plan in case well is D & A, then obtain approval of plan when calling district office prior to setting surface pipe.
6. Submit plugging report (CP-4) to K.C.C. after plugging is completed.
7. Obtain an approved injection docket number before disposing of salt water.
8. Notify K.C.C. within 10 days when injection commences or terminates.
9. If an alternate 2 completion, cement in the production pipe from below any usable water to surface within 120 days of spud date.

A Regular Section of Land
1 Mile = 5,280 Ft.

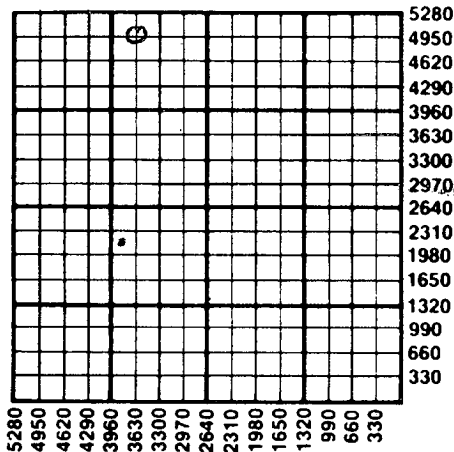

CONSERVATION DIVISION
Wichita, Kansas

SEP 11 1981

State Corporation Commission of Kansas
Conservation Division
200 Colorado Derby Building
Wichita, Kansas 67202-1212
(316) 263-3238