

NOTICE OF INTENTION TO DRILL

(see rules on reverse side)

Starting Date December 4, 1986
month day year

API Number 15- 135-23, 078-00-00
150' West of East
N/2 S.W. NE. Sec.27... Twp.16... S, Rg.21... X West
3630 Ft. from South Line of Section
2130 Ft. from East Line of Section

OPERATOR: License # 5255
Name McGinness Oil Company
Address 1026 Union Center Building
City/State/Zip Wichita, Kansas 67202
Contact Person Doug McGinness
Phone (316) 267-6065

(Note: Locate well on Section Plat on reverse side)
Nearest lease or unit boundary line 590 feet
County Ness
Lease Name Hinman Well # 1-27

CONTRACTOR: License # 5302
Name Red Tiger Drilling
City/State Wichita, Kansas

Ground surface elevation 2248 feet MSL
Domestic well within 330 feet: yes X no
Municipal well within one mile: yes X no
Depth to bottom of fresh water 200'
Depth to bottom of usable water 800'
Surface pipe by Alternate: 1 2 X

Well Drilled For: Well Class: Type Equipment:
X Oil SWD Infield X Mud Rotary
X Gas Inj Pool Ext Air Rotary
OWWO Expl Wildcat Cable

Surface pipe planned to be set 320'
Conductor pipe required None
Projected Total Depth 4250 feet
Formation Tight Hole

If OWWO: old well info as follows:

Operator
Well Name
Comp Date Old Total Depth

I certify that well will comply with K.S.A. 55-101, et seq. plus eventually plugging hole to KCC specifications.

Date 11-25-86 Signature of Operator or Agent [Signature] Title President


For KCC Use:

Conductor Pipe Required feet; Minimum Surface Pipe Required 250 feet per Alt. 10 B
This Authorization Expires 5-26-87 Approved By 11-26-86 [Signature]

Must be filed with the K.C.C. five (5) days prior to commencing well  
 This card void if drilling not started within six (6) months of date received by K.C.C.

**Important procedures to follow:**

**A Regular Section of Land**  
**1 Mile = 5,280 Ft.**

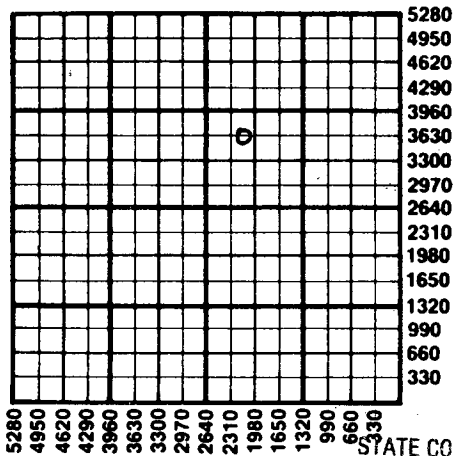

1. Notify District office before setting surface casing.
2. Set surface casing by circulating cement to the top.
3. File completion forms ACO-1 with K.C.C. within 90 days of well completion, following instructions on ACO-1, side 1, and including copies of wireline logs.
4. Notify District office 48 hours prior to old well workover or re-entry.
5. Prior to filing Intent, prepare a proposed plugging plan in case well is D & A, then obtain approval of plan when calling district office prior to setting surface pipe.
6. Submit plugging report (CP-4) to K.C.C. after plugging is completed.
7. Obtain an approved injection docket number before disposing of salt water.
8. Notify K.C.C. within 10 days when injection commences or terminates.

RECEIVED

STATE CORPORATION COMMISSION

9. If an alternate 2 completion, cement in the production pipe from below any usable water to surface within 120 days of spud date.

NOV 26 1984  
 11-26-1984  
 CONSERVATION DIVISION  
 Wichita, Kansas

State Corporation Commission of Kansas  
 Conservation Division  
 200 Colorado Derby Building  
 Wichita, Kansas 67202  
 (316) 263-3238