

CARD MUST BE TYPED

State of Kansas

CARD MUST BE SIGNED

# NOTICE OF INTENTION TO DRILL

(see rules on reverse side)

Starting Date July 16 1987  
month day year

API Number 15-135-23,141-00-00

OPERATOR: License # 5399  
Name American Energies Corporation  
Address 155 N. Market, Suite 710  
City/State/Zip Wichita, KS 67202  
Contact Person Alan L. DeGood  
Phone 263-5785

NW SE SW Sec. 24 Twp. 16 S, Rg. 21 X West  
990 Ft. from South Line of Section  
3630 Ft. from East Line of Section

(Note: Locate well on Section Plat on reverse side)

CONTRACTOR: License # 5147  
Name BEREDCO, INC.  
City/State Wichita, KS

Nearest lease or unit boundary line 990 feet  
County Ness  
Lease Name Baus "B" Well # 1

Well Drilled For:	Well Class:	Type Equipment:
<input checked="" type="checkbox"/> Oil	<input type="checkbox"/> SWD	<input checked="" type="checkbox"/> Mud Rotary
<input type="checkbox"/> Gas	<input type="checkbox"/> Inj	<input type="checkbox"/> Air Rotary
<input type="checkbox"/> OWWO	<input type="checkbox"/> Expl	<input checked="" type="checkbox"/> Wildcat
		<input type="checkbox"/> Cable

Ground surface elevation \_\_\_\_\_ feet MSL  
Domestic well within 330 feet:  yes  no  
Municipal well within one mile:  yes  no  
Depth to bottom of fresh water 200'  
Depth to bottom of usable water 650'  
Surface pipe by Alternate: 1 2   
Surface pipe planned to be set 300'  
Conductor pipe required \_\_\_\_\_  
Projected Total Depth 4200 feet  
Formation Mississippian

If OWWO: old well info as follows:

Operator \_\_\_\_\_  
Well Name \_\_\_\_\_  
Comp Date \_\_\_\_\_ Old Total Depth \_\_\_\_\_

I certify that well will comply with K.S.A. 55-101, et seq., plus eventually plugging hole to KCC specifications.

Date \_\_\_\_\_ Signature of Operator or Agent Alan L. DeGood Title Vice-President

For KCC Use:

Conductor Pipe Required \_\_\_\_\_ feet; Minimum Surface Pipe Required 200 feet per Alt. X(2)


This Authorization Expires 1-15-88 Approved By [Signature] 7-15-87

Must be filed with the K.C.C. five (5) days prior to commencing well  
This card void if drilling not started within six (6) months of date received by K.C.C.

### Important procedures to follow:

1. Notify District office before setting surface casing.
2. Set surface casing by circulating cement to the top.
3. File completion forms ACO-1 with K.C.C. within 90 days of well completion, following instructions on ACO-1, side 1, and including copies of wireline logs.
4. Notify District office 48 hours prior to old well workover or re-entry.  
Prior to filing Intent, prepare a proposed plugging plan in case well is D & A, then obtain approval of plan when calling district office prior to setting surface pipe.  
Submit plugging report (CP-4) to K.C.C. after plugging is completed.  
Obtain an approved injection docket number before disposing of salt water.
8. Notify K.C.C. within 10 days when injection commences or terminates.
9. If an alternate 2 completion, cement in the production pipe from below any usable water to surface within 120 days of spud date.

### A Regular Section of Land 1 Mile = 5,280 Ft.

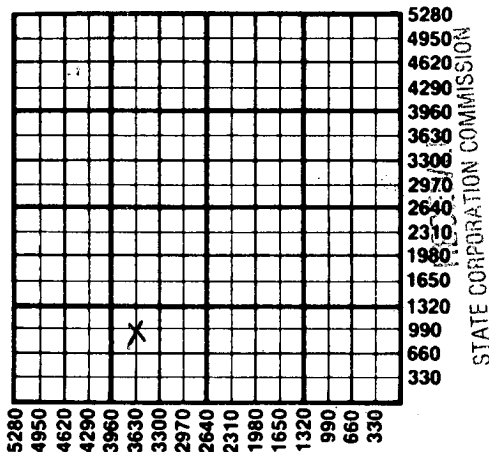

JUL 15 1987

CONSERVATION DIVISION  
Wichita, Kansas

07-15-1987

State Corporation Commission of Kansas  
Conservation Division  
200 Colorado Derby Building  
Wichita, Kansas 67202  
(316) 263-3238