

SIDE ONE

Two (2) copies of this form shall be filed with the Kansas Corporation Commission, 200 Colorado Derby Building, Wichita, Kansas 67202, within thirty (30) days after the completion of a well, regardless of how the well was completed.

Attach separate letter of request if the information is to be held confidential. If confidential, only file one copy. Information on Side One will be of public record and Side Two will then be held confidential.

Applications must be made on dual completion, commingling, salt water disposal, injection and temporarily abandoned wells.

Attach one copy only wireline logs (i.e. electrical log, sonic log, gamma ray neutron log, etc.). (Rules 82-2-105 & 82-2-125) KCC# (316) 263-3238.

LICENSE # 5151 EXPIRATION DATE 1983

OPERATOR Gear Petroleum Co, Inc API NO. 15-101-20,706 00-00

ADDRESS 300 Sutton Place COUNTY Lane

Wichita, Kansas 67202 FIELD Wildcat ROEMER EXT.

\*\* CONTACT PERSON Jim Thatcher PROD. FORMATION Marmaton PHONE 316 265 3351

PURCHASER Clear Creek, Inc. LEASE Roemer

ADDRESS P. O. Box 1045 WELL NO. 1-18


McPherson, Kansas 67460 WELL LOCATION SW SW NW

DRILLING Contractor Warrior Drilling Company 490 Ft. from South Line and

ADDRESS 905 Century Plaza 340 Ft. from West Line of

Wichita, Kansas 67202 the NW (Qtr.) SEC 18 TWP 16S RGE 29W.

PLUGGING CONTRACTOR ADDRESS

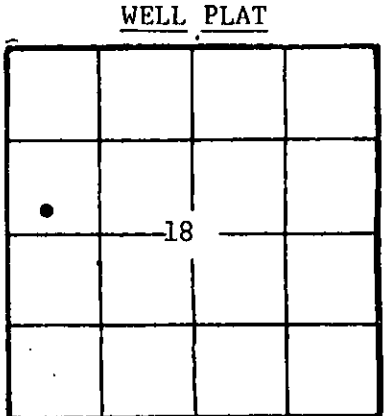

(Office Use Only) KCC [checked] KGS [checked] SWD/REP PLG.

TOTAL DEPTH 4540 PBTD

SPUD DATE 9/10/82 DATE COMPLETED 9/21/82

ELEV: GR 3823 DF KB 2830

DRILLED WITH (SANK) (ROTARY) (SK) TOOLS.

DOCKET NO. OF DISPOSAL OR REPRESSURING WELL BEING USED TO DISPOSE OF WATER FROM THIS LEASE

Amount of surface pipe set and cemented 8 5/8 at 324 DV Tool Used? No

THIS AFFIDAVIT APPLIES TO: (Circle ONE) - Oil, Gas, Shut-in Gas, Dry, Disposal, Injection, Temporarily Abandoned, OWWO. Other

ALL REQUIREMENTS OF THE STATUTES, RULES AND REGULATIONS PROMULGATED TO REGULATE THE OIL AND GAS INDUSTRY HAVE BEEN FULLY COMPLIED WITH.

A F F I D A V I T

Jim Thatcher, Drilling & Production Mgr., being of lawful age, hereby certifies that:

I am the Affiant, and I am familiar with the contents of the foregoing Affidavit. The statements and allegations contained therein are true and correct.

Signature of Jim Thatcher (Name)

SUBSCRIBED AND SWORN TO BEFORE ME this 8th day of October, 1982.

HELEN L. COVER NOTARY PUBLIC STATE OF KANSAS My Appt. Exp. 4-1-86

Signature of Helen L. Cover (NOTARY PUBLIC)

MY COMMISSION EXPIRES: April 1, 1986

\*\* The person who can be reached by phone regarding any questions concerning this information.

RECEIVED STATE CORPORATION COMMISSION OCT 13 1982 10-13-1982 CONSERVATION DIVISION Wichita, Kansas