


15-101-21013-0000

STATE OF KANSAS  
STATE CORPORATION COMMISSION

WELL PLUGGING RECORD

Give All Information Completely  
Make Required Affidavit  
Mail or Deliver Report to  
Conservation Division  
State Corporation Comm.  
245 North Water  
Wichita, KS 67202

Lane \_\_\_\_\_ County, Sec. 27 Twp. 17S Rge. 27 NE/W  
Location as "NE/CNW $\frac{1}{4}$ SW $\frac{1}{4}$ " or footage from lines \_\_\_\_\_  
SW SE SW  
Lease Owner Vicorp Energy Inc. #6732  
Lease Name Mumma Well No. 1  
Office Address 6200 S. Syracuse Way # 125, Denver, CO 80111  
Character of Well (Completed as Oil, Gas or Dry Hole) \_\_\_\_\_  
DRY HOLE

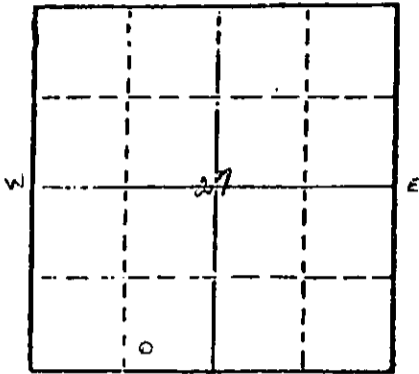

Date Well completed 8-18-1984  
Application for plugging filed 8-17-1984  
Application for plugging approved 8-17-1984  
Plugging commenced 8-18-1984  
Plugging completed 8-18-1984  
Reason for abandonment of well or producing formation \_\_\_\_\_  
DRY HOLE

If a producing well is abandoned, date of last production 19

Was permission obtained from the Conservation Division or its agents before plugging was commenced? YES (CL)

Name of Conservation Agent who supervised plugging of this well Paul Luthi  
Producing formation \_\_\_\_\_ Depth to top \_\_\_\_\_ Bottom \_\_\_\_\_ Total Depth of Well 4675'  
Show depth and thickness of all water, oil and gas formations.

OIL, GAS OR WATER RECORDS

CASING RECORD

FORMATION	CONTENT	FROM	TO	SIZE	PUT IN	PULLED OUT
Surface		0	387'	8 5/8	384'	0

Describe in detail the manner in which the well was plugged, indicating where the mud fluid was placed and the method or methods used in introducing it into the hold. If cement or other plugs were used, state the character of same and depth placed, from \_\_\_\_\_ feet to \_\_\_\_\_ feet for each plug set.

4675' T.D. 175 Sacks 60-40 Posmix 2% Gel 3% cc  
1st Plug @ 2060' with 50 Sacks  
2nd Plug @ 1330' with 50 Sacks  
3rd Plug @ 430' with 50 Sacks  
Solid Bridge @ 40' with 10 Sacks  
Rathole with 15 Sacks  
Plug down 9:45 A.M. 8-18-84  
Sun Cementing

(If additional description is necessary, use BACK of this sheet)

Name of Plugging Contractor Blue Goose Drilling Company, Inc.

STATE OF KANSAS COUNTY OF BARTON, ss.  
George E. Miller, Jr. (employee or owner) or (owner or operator)  
of the above-described well, being first duly sworn on oath, says: That I have knowledge of the facts, statements, and matters herein contained and the log of the above-described well as filed and that the same are true and correct. So help me God.

(Signature) George E. Miller, Jr.  
P.O. Box 1413 Great Bend, KS 67530  
(Address)

SUBSCRIBED AND SWORN TO before me this 21st day of August, 19 84

Helen C. Standley  
Notary Public.

My commission expires 12-8-87

HELEN C. STANDLEY  
Barton County, Kansas  
My Appt. Exp. 12-8-87

RECEIVED  
STATE CORPORATION COMMISSION  
SEP 13 1984