

15-101-20104-00-00


STATE OF KANSAS
STATE CORPORATION COMMISSION

Form CP-4

Give All Information Completely
Make Required Affidavit
Mail or Deliver Report to:
Conservation Division
State Corporation Commission
P. O. Box 17027
Wichita, Kansas 67217
NORTH

WELL PLUGGING RECORD

Lane _____ County, Sec. 27 Twp. 17S Rge. 27 (E) X (W)
Location as "NE/CNW/SE" or footage from lines SE SW NE
Lease Owner Mull Drilling Company, Inc.
Lease Name Mumma Well No. 1
Office Address 415 Page Ct., 220 W. Douglas, Wichita, Ks. 67202
Character of Well (completed as Oil, Gas or Dry Hole) Dry Hole
Date well completed 7-17-74 19
Application for plugging filed 7-17-74 19
Application for plugging approved 7-17-74 19
Plugging commenced 7-17-74 19
Plugging completed 7-18-74 19
Reason for abandonment of well or producing formation commercial quantities of oil not found.
If a producing well is abandoned, date of last production 19
Was permission obtained from the Conservation Division or its agents before plugging was commenced? yes

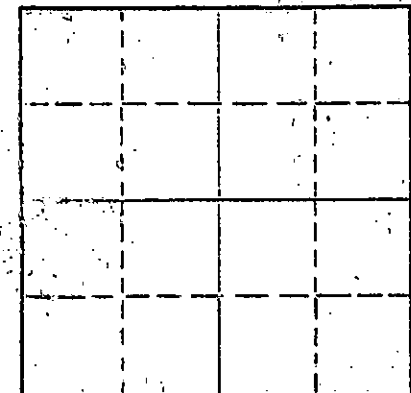

Locate well correctly on above
Section Plat

Name of Conservation Agent who supervised plugging of this well W. L. Nichols-Morland, Kansas
Producing formation _____ Depth to top _____ Bottom _____ Total Depth of Well 4649 Feet
Show depth and thickness of all water, oil and gas formations.

OIL, GAS OR WATER RECORDS

CASING RECORD

FORMATION	CONTENT	FROM	TO	SIZE	PUT IN	PULLED OUT
				8-5/8"	287'	

Describe in detail the manner in which the well was plugged, indicating where the mud fluid was placed and the method or methods used in introducing it into the hole. If cement or other plugs were used, state the character of same and depth placed, from _____ feet to _____ feet for each plug set.

1st plug @ 950' with 70 sx.
2nd plug @ 300' with 20 sx.
Top plug @ 40' with 10 sx.

RECEIVED
STATE CORPORATION COMMISSION
AUG 6 1974
CONSERVATION DIVISION
Wichita, Kansas

(If additional description is necessary, use BACK of this sheet)

Name of Plugging Contractor Rains & Williamson Oil Co., Inc.
Address 435 Page Court, 220 W. Douglas, Wichita, Kansas 67202

STATE OF KANSAS COUNTY OF SEDGWICK ss.
Wilson Rains

(employee of owner) or (owner or operator) of the above-described well, being first duly sworn on oath, says: That I have knowledge of the facts, statements, and matters herein contained and the log of the above-described well as filed and that the same are true and correct. So help me God.

(Signature)

WILSON RAINS
435 Page Court, Wichita, Ks. 67202
(Address)



Subscribed and sworn to before me this 22nd day of July 1974
My commission expires October 4, 1975

Juanita M. Green
Notary Public

WELL LOG

15-101-20104-00-00

COMPANY Mull Drilling Company, Inc.

SEC. 27 T. 17S R. 27W

FARM Mumma

NO. 1

LOC. SE SW NE

RIG. NO. 4


TOTAL DEPTH 4649'

COMM. 6-15-74

COMP. 7-18-74

COUNTY Lane
KANSAS

CONTRACTOR Rains & Williamson Oil Co., Inc.

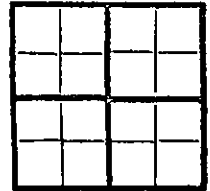

CASINO

20 10
15 8-5/8" @ 287' w/175 sx. common, 3% gel ELEVATION
12 6 2% cc.
10 5

PRODUCTION D & A

FIGURES INDICATE BOTTOM OF FORMATIONS

Post Rock	40
Sand and Shale	180
Shale and Sand	297
Shale	500
Shale and Shells	1207
Shale	1570
Shale and Sand	2090
Sand and Shale	2095
Anhydrite	2126
Shale	2450
Shale and Lime	2975
Lime and Shale	3135
Shale and Lime	3600
Lime and Shale	3970
Lime	4649
<u>Rotary Total Depth</u>	<u>4649</u>

RECEIVED
STATE CORPORATION COMMISSION
AUG 6 1974
CONSERVATION DIVISION
Wichita, Kansas

State of KANSAS
County of SEDGWICK ss:

I, Wilson Rains, President of the Rains & Williamson Oil Co., Inc. Companyupon oath state that the above and foregoing is a true and correct copy of the log of the Mumma #1 well.

Wilson Rains
WILSON RAINS
19 74
Juanita M. Green
NOTARY PUBLIC
Juanita M. Green