


15-101-20370-00-00

FORM CP-4

STATE OF KANSAS
STATE CORPORATION COMMISSION

WELL PLUGGING RECORD

Give All Information Completely
Make Required Affidavit
Mail or Deliver Report to
Conservation Division
State Corporation Comm.
245 North Water
Wichita, KS 67202

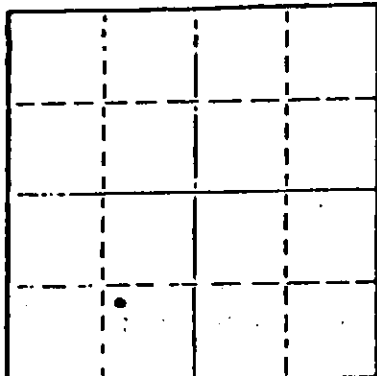

Locate well correctly on above
Section Plot

Lane _____ County. Sec. 26 Twp. 17S Rge. 27 ~~NE~~
Location as "NE/CNW/SW" or footage from lines _____
NW SE SW

Lease Owner Mull Drilling Co., Inc.

Lease Name Repshire Well No. 1

Office Address 221 N. Main Suite 300 Wichita, Ks. 67202

Character of Well (Completed as Oil, Gas or Dry Hole) _____

Dry-Hole

Date Well completed 2-13-1979

Application for plugging filed 2-13-1979

Application for plugging approved 2-13-1979

Plugging commenced 2-13-1979

Plugging completed 2-13-1979

Reason for abandonment of well or producing formation _____

Dry-Hole

If a producing well is abandoned, date of last production 19 _____

Was permission obtained from the Conservation Division or
its agents before plugging was commenced? Yes

Name of Conservation Agent who supervised plugging of this well Gilbert Balthazor

Producing formation _____ Depth to top _____ Bottom _____ Total Depth of Well _____

Show depth and thickness of all water, oil and gas formations.

OIL, GAS OR WATER RECORDS

CASING RECORD

FORMATION	CONTENT	FROM	TO	SIZE	PUT IN	PULLED OUT
Surface casing		-0-	328'	8 5/8"	317.94'	

Describe in detail the manner in which the well was plugged, indicating where the mud fluid was placed and the method or methods used in introducing it into the hold. If cement or other plugs were used, state the character of same and depth placed, from _____ feet to _____ feet for each plug set.

Plug #1 - 800' with 70 sacks cement.

Plug #2 - 300' with 20 sacks cement.

Plug #3 - 40' with 10 sacks cement.

RECEIVED
STATE CORPORATION COMMISSION
FEB 20 1979
CONSERVATION DIVISION
WICHITA, KANSAS

(If additional description is necessary, use BACK of this sheet)

Name of Plugging Contractor Blue Goose Drilling Co., Inc.

STATE OF Kansas COUNTY OF Barton ss.

George E. Miller, Jr.

_____, (owner or operator) of the above-described well, being first duly sworn on oath, says: That I have knowledge of the facts, statements, and matters herein contained and the log of the above-described well as filed and that the same are true and correct. So help me God.

(Signature)

George E. Miller, Jr.

(Address)


Subscribed and sworn to before me this 17th day of February 1979

My commission expires

8-1-81

Mary Ann Schumacher

Notary Public.

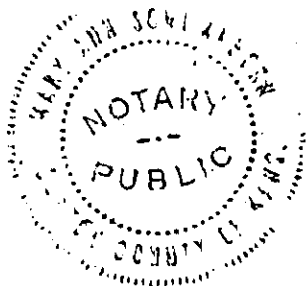

15-101-20370-00-00

WELL LOG
Repshire #1
NW SE SW Sec. 26-17S-27W
Lane County, Kansas

Name of Operator: Mull Drilling Co., Inc.
221 N. Main, Suite 300
Wichita, Kansas 67202

Date Completed: February 13, 1979

FROM	TO	
0	328	Surface soil & sand
328	1035	Shale and sand
1035	1600	Shale
1600	2210	Shale and sand
2210	2400	Shale
2400	2854	Shale and sand
2854	4085	Shale and lime
4085	4205	Lansing lime and shale
4205	4475	Shale and lime
4475	4511	Lime
4511	4560	Shale and lime
4560	4586	Cherokee shale and lime
4586	4650	Shale and lime
4650		Total Depth

STATE OF KANSAS

COUNTY OF BARTON ss

George E. Miller, Jr., President of Blue Goose Drilling Co., Inc.
being first duly sworn on oath says: That I have knowledge of the facts,
statements and matters herein contained and the log of the above described well
as filed and that the same are true and correct.


George E. Miller, Jr.

Subscribed and sworn before me this 16th day of February, 1979.


Notary Public Barton County

My Commission Expires 8-1-81

