


STATE OF KANSAS
STATE CORPORATION COMMISSION

WELL PLUGGING RECORD

Give All Information Completely
Make Required Affidavit
Mail or Deliver Report to
Conservation Division
State Corporation Comm.
245 North Water
Wichita, KS 67202

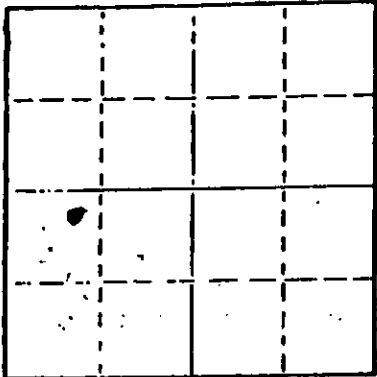

Lane _____ County. Sec. 34 Twp. 17S Rge. 27W E/W
Location as "NE/CNW/SW" or footage from lines _____

NE NW SW
Lease Owner Mull Drilling Co., Inc.
Lease Name Brown A Well No. 1
Office Address 415 Page Court, 220 W. Douglas, Wichita, Kans
Character of Well (Completed as Oil, Gas or Dry Hole) _____

Dry Hole
Date Well completed 7-5 19 77
Application for plugging filed 7-5 19 77
Application for plugging approved 7-5 19 77
Plugging commenced 7-5 19 77
Plugging completed 7-5 19 77
Reason for abandonment of well or producing formation _____

D & A
If a producing well is abandoned, date of last production 19 _____

Was permission obtained from the Conservation Division or its agents before plugging was commenced? Yes

Name of Conservation Agent who supervised plugging of this well Gilbert Dalthazor
Producing formation _____ Depth to top _____ Bottom _____ Total Depth of Well _____
Show depth and thickness of all water, oil and gas formations.

OIL, GAS OR WATER RECORDS

CASING RECORD

FORMATION	CONTENT	FROM	TO	SIZE	PUT IN	PULLED OUT
Surface pipe		-0-	281'	8 5/8"	281'	None

Describe in detail the manner in which the well was plugged, indicating where the mud fluid was placed and the method or methods used in introducing it into the hold. If cement or other plugs were used, state the character of same and depth placed, from _____ feet to _____ feet for each plug set.

RECEIVED
STATE CORPORATION COMMISSION

JUL 08 1977

Filled hole with heavy mud.

- #1 Plug set @ 800' with 70 sks. cement.
- #2 Plug set @ 240' with 20 sks. cement.
- #3 Plug set @ 40' with 10 sks. cement.

CONSERVATION DIVISION
Wichita, Kansas

(If additional description is necessary, use BACK of this sheet)

Name of Plugging Contractor Blue Goose Drilling Co., Inc.
Box 1413, Great Bend, Kansas 67530

STATE OF Kansas COUNTY OF Barton ss.

George E. Miller, Jr.

(owner or operator) of the above-described

well, being first duly sworn on oath, says: That I have knowledge of the facts, statements, and matters herein contained and the log of the above-described well as filed and that the same are true and correct. So help me God.

(Signature)


Box 1413, Great Bend, Kansas 67530

(Address)

Subscribed and Sworn to before me this 12th day of July 1977

Mary Ann Schumacher
Notary Public.

7-10-77

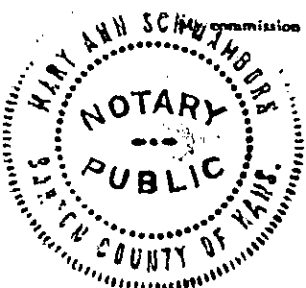

15-101-20209-00-06

WELL LOG

Brown A #1
NE NW SW 34-17S-27W
Lane County, Kansas

Name of Operator: Mull Drilling Co., Inc.
415 Page Court, 220 W. Douglas
Wichita, Kansas 67202

Date Completed: July 5, 1977

<u>FROM</u>	<u>TO</u>	
0	2039	Sand and shale
2039	2068	Anhydrite
2068	2333	Shale and shells
2333	2440	Shale
2440	4590	Lime and shale
4590	4620	Lime
4620		Total Depth

RECEIVED
STATE CONSERVATION COMMISSION

JUL 08 1977

CONSERVATION DIVISION
Wichita, Kansas

STATE OF KANSAS

COUNTY OF BARTON

George E. Miller, Jr., President of Blue Goose Drilling Co., Inc.,
being first duly sworn on oath says: That I have knowledge of the facts, statements
and matters herein contained and the log of the above described well as filed
and that the same are true and correct.


George E. Miller, Jr.

Subscribed and sworn before me this 6th day of July, 1977.


NOTARY PUBLIC Barton County

My Commission Expires 7-10-77

