

CARD MUST BE TYPED

State of Kansas  
**NOTICE OF INTENTION TO DRILL**  
(see rules on reverse side)

CARD MUST BE SIGNED

Starting Date: September 13, 1984  
month day year 2:55

API Number 15- 101-21,045-0000

OPERATOR: License # 5408 & 5088

N/2.. SE/4.NE/4 Sec 17.. Twp 17.. S, Rge .28.  East  
(location)  West

Name Moble, C., Hoover, & John Jay Darrah, Jr.

Address 405 Century Plaza Building

City/State/Zip Wichita, Kansas 67202

Contact Person Bq. Darrah

Phone 316-263-2243

3630 ..... Ft North from Southeast Corner of Section

660 ..... Ft West from Southeast Corner of Section

(Note: Locate well on Section Plat on reverse side)

CONTRACTOR: License #

Nearest lease or unit boundary line 660 ..... feet.

County Lane

Lease Name Richards Well# 1

Domestic well within 330 feet:  yes  no

Municipal well within one mile:  yes  no

Well Drilled For: Well Class: Type Equipment:

Oil  Swd  Infield  Mud Rotary

Gas  Inj  Pool Ext.  Air Rotary

OWWO  Expl  Wildcat  Cable

Depth to Bottom of fresh water 10.3 ..... feet

Lowest usable water formation Dakota

Depth to Bottom of usable water 1100 ..... feet

Surface pipe by Alternate: 1  2

Surface pipe to be set 320 ..... feet

Conductor pipe if any required ..... feet

Ground surface elevation ..... feet MSI.

This Authorization Expires 3-11-85

Approved By 9-11-84

If OWWO: old well info as follows:

Operator

Well Name

Comp Date Old Total Depth

Projected Total Depth 4650 ..... feet

Projected Formation at TD Mississippi

Expected Producing Formations Lansing/Cherokee

I certify that we will comply with K.S.A. 55-101, et seq., plus eventually plugging hole to K.C.C. specifications

Date Sept. 11, 1984 Signature of Operator or Agent


Title Operator

mhc/USOHE 9/11/84

Must be filed with the K.C.C. five (5) days prior to commencing well  
This card void if drilling not started within six (6) months of date received by K.C.C.

Wichita, Kansas  
NOISEAID NOTIAHES  
h8-11-6  
1986  
SEP 11 1986

STATE CORPORATION COMMISSION  
A Regulatory Section of Land  
1 Mile = 5,280 Ft.

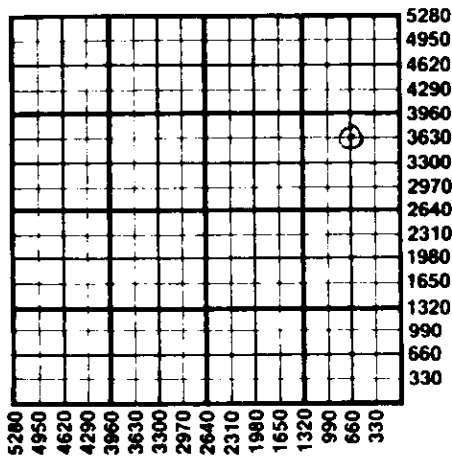

**Important procedures to follow :**

1. Notify District office before setting surface casing.
2. Set surface casing by circulating cement to the top.
3. File completion forms ACO-1 with K.C.C. within 90 days of well completion, following instructions on ACO-1, side 1, and including copies of wireline logs.
4. Notify District office 48 hours prior to old well workover or re-entry.
5. Prior to plugging, prepare a plugging plan, then obtain agreement from the appropriate district office for an approved plugging plan.
6. Submit plugging report (CP-4) to K.C.C. after plugging is completed.
7. Obtain an approved injection docket number before disposing of salt water.
8. Notify K.C.C. within 10 days when injection commences or terminates.
9. If an alternate 2 completion, cement in the production pipe from below any usable water to surface within 120 days of spud date.

State Corporation Commission of Kansas  
Conservation Division  
200 Colorado Derby Building  
Wichita, Kansas 67202  
(316) 263-3238