


15-135-22377-0000

STATE OF KANSAS  
STATE CORPORATION COMMISSION

WELL PLUGGING RECORD

Give All Information Completely  
Make Required Affidavit  
Mail or Deliver Report to  
Conservation Division  
State Corporation Comm.  
245 North Water  
Wichita, KS 67202

Ness County. Sec. 19 Twp. 17S Rge. 22 NE/W  
Location as "NE/CNW 1/4 SW 1/4" or footage from lines  
NE NW SW  
Lease Owner Sunburst Exploration Co., Inc.  
Lease Name Pomije Well No. 1  
Office Address 708 One Main Pl. Wichita, KS 67202  
Character of Well (Completed as Oil, Gas or Dry Hole)

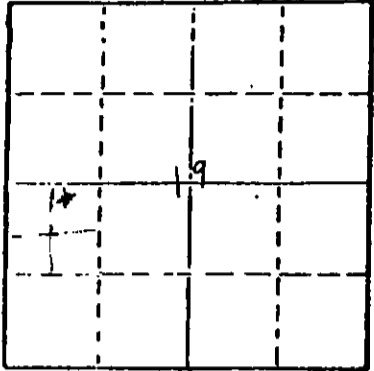

Locate well correctly on above  
Section Plat

DRY HOLE  
Date Well completed 3-31-1983  
Application for plugging filed 3-31-1983  
Application for plugging approved 3-31-1983  
Plugging commenced 3-31-1983  
Plugging completed 3-31-1983  
Reason for abandonment of well or producing formation  
Dry Hole

If a producing well is abandoned, date of last production 19

Was permission obtained from the Conservation Division or  
its agents before plugging was commenced? YES

Name of Conservation Agent who supervised plugging of this well Richard Lacey  
Producing formation \_\_\_\_\_ Depth to top \_\_\_\_\_ Bottom \_\_\_\_\_ Total Depth of Well 4520'  
Show depth and thickness of all water, oil and gas formations.

OIL, GAS OR WATER RECORDS

CASING RECORD

FORMATION	CONTENT	FROM	TO	SIZE	PUT IN	PULLED OUT
		0	328'	8 5/8	325	0

Describe in detail the manner in which the well was plugged, indicating where the mud fluid  
was placed and the method or methods used in introducing it into the hold. If cement or other  
plugs were used, state the character of same and depth placed, from \_\_\_\_\_ feet to  
\_\_\_\_\_ feet for each plug set.

T. D. 4520' 150 Sacks 50-50 Posmix 4% Gel 3% cc  
1st Plug at 1680' with 50 Sacks  
2nd Plug at 840' with 40 Sacks  
3rd Plug at 360' with 40 Sacks  
4th Plug at 40' with 10 Sacks Solid Bridge  
Circulated 10 Sacks thru jointed drill pipe in Rathole  
Plug down 6:30 A.M. 3-31-83

(If additional description is necessary, use BACK of this sheet)

Name of Plugging Contractor Blue Goose Drilling Co., Inc. # 5104

STATE OF KANSAS COUNTY OF BARTON, ss.  
George E. Miller, Jr. (owner or operator)  
of the above-described well, being first duly sworn on oath, says: That I have knowledge of  
the facts, statements, and matters herein contained and the log of the above-described well  
as filed and that the same are true and correct. So help me God.

(Signature) George E. Miller, Jr.  
P.O. Box 1413 Great Bend, KS 67530  
(Address)

SUBSCRIBED AND SWORN TO before me this 31st day of March, 1983

Helen C. Standley  
Notary Public.

My commission expires 12-8-83

HELEN C. STANDLEY  
Barton County, Kansas  
My Appt. Exp. 12-8-83

RECEIVED  
STATE CORPORATION COMMISSION

APR 13 1983

CONSERVATION DIVISION  
Wichita, Kansas

15.135-22377-0000

WELL LOG

POMIJE # 1  
NE NW SE Sec 19-17S-22W  
Ness County, KS

NAME OF OPERATOR: Sunburst Exploration Co., Inc.  
708 One Main Place  
Wichita, KS 67202

DATE COMPLETED: March 31, 1983

FROM	TO	
0	100	Sand and Shale
100	115	Sand
115	328	Shale
328	1360	Sand and Shale
1360	1845	Shale and Redbed
1845	2355	Sand and Shale
2355	4520	Shale and Lime
4520		T.D.


STATE OF KANSAS

COUNTY OF BARTON ss

George E. Miller, Jr., President of Blue Goose Drilling Company, Inc., being first duly sworn on oath says: That I have knowledge of the facts, statements and matters herein contained and the log of the above described well as filed and that the same are true and correct.

*George E. Miller, Jr.*  
George E. Miller, Jr.

Subscribed and sworn before me this 1st Day of April 1983.

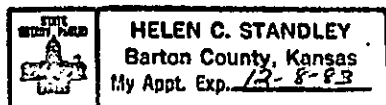

*Helen C. Standley*

Helen C. Standley, Notary Public

My Commission Expires: 12-8-83

RECEIVED  
STATE CORPORATION COMMISSION  
APR 13 1983  
CONSERVATION DIVISION  
Wichita, Kansas