

15-135-19079-00-00

STATE OF KANSAS  
STATE CORPORATION COMMISSION

Form CP-4

Give All Information Completely  
Make Required Affidavit  
Mail or Deliver Report to:  
Conservation Division  
State Corporation Commission  
311 No. Broadway  
Wichita, Kansas

WELL PLUGGING RECORD

Ness County, Sec. 25 Twp. 17s Rge 22w (E) (W)

Location as "NE/CNW/SW" or footage from lines G NW NW

Lease Owner Virginia Drilling Co., Inc.

Lease Name Edward Water Well No. 1

Office Address 712 Brown Bldg., Wichita, Kansas 67202

Character of Well (completed as Oil, Gas or Dry Hole) dry hole

Date well completed July 22 19 63

Application for plugging filed 19 63

Application for plugging approved 19 63


Plugging commenced 19 63

Plugging completed 19 63

Reason for abandonment of well or producing formation

If a producing well is abandoned, date of last production 19

Was permission obtained from the Conservation Division or its agents before plugging was commenced? yes

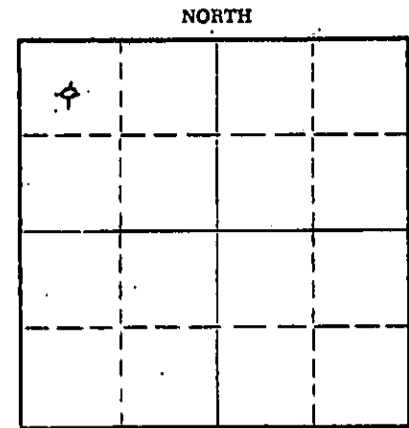

Locate well correctly on above Section Plat

Name of Conservation Agent who supervised plugging of this well Eldon Petty

Producing formation Depth to top Bottom Total Depth of Well 4327 Feet

Show depth and thickness of all water, oil and gas formations.

OIL, GAS OR WATER RECORDS

CASING RECORD

FORMATION	CONTENT	FROM	TO	SIZE	PUT IN	PULLED OUT
		0	260	8-5/8"	260	none

Describe in detail the manner in which the well was plugged, indicating where the mud fluid was placed and the method or methods used in introducing it into the hole. If cement or other plugs were used, state the character of same and depth placed, from feet to feet for each plug set.

Mudded to 540 ft. - set plug w/20 sx cement  
Mudded to 240 ft. - set plug w/20 sx cement  
Mudded to 40 ft. - set plug w/10 sc. cement

RECEIVED  
STATE CORPORATION COMMISSION

JUL 29 1963

CONSERVATION DIVISION  
Wichita, Kansas

(If additional description is necessary, use BACK of this sheet)

Name of Plugging Contractor Virginia Drilling Co., Inc.

Address 712 Brown Bldg., Wichita, Kansas 67202

STATE OF Kansas, COUNTY OF Sedgwick, ss.

S. A. Murphy (employee of owner) or (owner or operator) of the above-described well, being first duly sworn on oath, says: That I have knowledge of the facts, statements, and matters herein contained and the log of the above-described well as filed and that the same are true and correct. So help me God.

(Signature) S. A. Murphy

712 Brown Bldg., Wichita, Kansas 67202 (Address)

SUBSCRIBED AND SWORN TO before me this 25th day of July, 19 63

Inez M. Underwood Notary Public.

My commission expires March 15, 1966

Well: Edward Mater #1  
 Location: Center NW NW, Section 25-17s-22w, Ness Co., Kansas  
 Company: Virginia Drilling Co., Inc.  
 Contractor: Virginia Drilling Co., Inc.  
 Commenced: July 11, 1963  
 Completed: July 22, 1963  
 Total Depth: 4330  
 Elevation: 2226 K. B.

**RECEIVED**  
 STATE CORPORATION COMMISSION  
 JUL 29 1963  
 CONSERVATION DIVISION  
 Wichita, Kansas

FORMATION	DEPTH
Clay	0-40
Clay-shale	40-260
Shale-shells	260-725
Shale-shells-Red Bed	725-885
Sand	885-1165
Red Bed	1165-1415
Red Bed-shale	1415-1465
Anhydrite	1465-1500
Shale	1500-2070
Shale-shells	2070-2165
Shale-lime	2165-2305
Lime	2305-2340
Lime-shale	2340-2460
Lime	2460-2545
Lime-shale	2545-2742
Shale-shells	2742-2780
Lime-shale	2780-2935
Lime	2935-2910
Lime-shale	2910-3090
Shale-shells	3090-3150
Lime	3150-3255
Lime-shale	3255-3800
Lime	3800-4330 T.D.


Set 8-5/8" csg. @ 260'

TOPS:

Heebner	3619
Toronto	3641
Lansing K.C.	3663
Base of K. C.	3944
Pawnee	4039
Upper Cherokee Shale	4114
Ft. Scott	4124
Cherokee Sand	4147
Mississippi	4220
Gilmer City	4294

1<sup>st</sup> Drill Stem 4228-40  
 Recovered 110' muddy water.

Now comes S. A. Murphy, who states that he is familiar with the drilling of oil and gas wells, and knows of his own knowledge that the Edward Mater #1, located in the center of the Northwest Northwest (NW NW), Section 25-17s-22w, Ness County, Kansas, was drilled to a depth of 4330 feet.

  
 S. A. Murphy

Subscribed and sworn to before me, a Notary Public, this 23<sup>rd</sup> day of July, 1963.

  
 Notary Public