


STATE OF KANSAS
STATE CORPORATION COMMISSION

WELL PLUGGING RECORD

Give All Information Completely
Make Required Affidavit
Mail or Deliver Report to:
Conservation Division
State Corporation Commission
212 No. Market
Wichita, Kansas

Ness County, Sec. 26 Twp. 17S Rge. (E)22 (W)
Location as "NE/CNW/SW" or footage from lines C SE NW
Lease Owner Leben Drilling, Inc.
Lease Name Lamer Well No. 1
Office Address P.O. Box 486 Great Bend, Kansas
Character of Well (completed as Oil, Gas or Dry Hole) dry hole
Date well completed January 19 19 70
Application for plugging filed January 19 19 70
Application for plugging approved January 19 19 70
Plugging commenced January 19 19 70
Plugging completed January 19 19 70
Reason for abandonment of well or producing formation dry hole

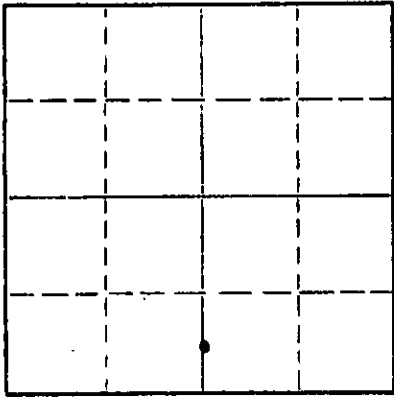

Locate well correctly on above
Section Plot

If a producing well is abandoned, date of last production 19
Was permission obtained from the Conservation Division or its agents before plugging was commenced? yes

Name of Conservation Agent who supervised plugging of this well Leo Massey
Producing formation _____ Depth to top _____ Bottom _____ Total Depth of Well 4280 Feet
Show depth and thickness of all water, oil and gas formations.

OIL, GAS OR WATER RECORDS

CASING RECORD

FORMATION	CONTENT	FROM	TO	SIZE	PUT IN	PULLED OUT
				8 5/8"	329'	none

Describe in detail the manner in which the well was plugged, indicating where the mud fluid was placed and the method or methods used in introducing it into the hole. If cement or other plugs were used, state the character of same and depth placed, from _____ feet to _____ feet for each plug set.

Plugged hole as follows: Heaby mud from 660'; plug w/70 sacks cement; heavy mud to 300' plug w/20 sacks cement; hevay mud to 40' plug bridged, w/Kelley & 10 sacks cement total 100 sacks 50/50 Pozmix w/6% Gel.

(If additional description is necessary, use BACK of this sheet)

Name of Plugging Contractor Leben Drilling, Inc.
Address P.O. Box 486 Great Bend, Kansas

STATE OF Kansas, COUNTY OF Barton, ss.
James R. Rodgers (employee of owner) or (owner or operator) of the above-described well, being first duly sworn on oath, says: That I have knowledge of the facts, statements, and matters herein contained and the log of the above-described well as filed and that the same are true and correct. So help me God.

(Signature) James R. Rodgers
P.O. Box 486 Great Bend, Kansas
(Address)

SUBSCRIBED AND SWORN TO before me this 4th day of February, 19 70

John L. Lindemann

My commission expires November 13, 1973

RECEIVED
STATE CORPORATION COMMISSION
FEB 6 1970
CONSERVATION DIVISION
Wichita, Kansas

WELL LOG

Company Leben Drilling, Inc.

Sec. 26 T. 17S R. 22W

Contractor Leben Drilling, Inc.

Loc. C SE NW

Farm Lamer #1

County Ness


Total Depth 4280' RTD

Casing 8 5/8" 20# Set @ 329' w/200
sxs. Common 2% C.C.

Commenced 1-12-70

Production D & A

Completed 1-19-70

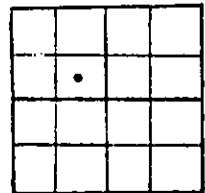

Figures Indicate Bottom of Formations

0	60	Surface Clay, Sand, & Post Rock
60	330	Shale & Sand
330	600	Shale
600	819	Red Bed
819	830	Blaine & Anhydrite
830	990	Red Bed
990	1175	Sand
1175	1490	Red Bed
1490	1526	Anhydrite
1526	1934	Shale
1934	3675	Lime & Shale
3675	4280	Lime
	<u>4280</u>	<u>RTD D & A.</u>

State of Kansas)
)
County of Barton) SS

RECEIVED
STATE CORPORATION COMMISSION
FEB 6 1970
CONSERVATION DIVISION
Wichita, Kansas

I, James R. Rodgers of the Leben Drilling, Inc.
upon oath state that the above and foregoing is a true and correct copy
of the log of the Lamer #1 Well.

James R. Rodgers

Subscribed and sworn to before me this 4th day of February, 1970

My Commission Expires:
November 13, 1973

Allen L. Lindemann