


STATE OF KANSAS
STATE CORPORATION COMMISSION
200 Colorado Derby Bldg.
Wichita, Kansas 67202

Form CP-4
Rev. 12-15-80

WELL PLUGGING RECORD

Give All Information Completely
Make Required Affidavit

COUNTY Ness SEC. 27 TWP. 17S RGE. 22W E/W
Location as in quarters or footage from lines:
1320' FEL; 660' FSL

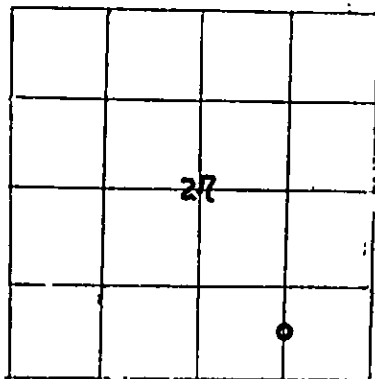

Locate Well
correctly on above
Section Platt.

Lease Owner Energy Methods Corporation
Lease Name Thompson Well No. 1-27
Office Address 1616 Glenarm Pl., Suite 2850, Denver, Co. 80202
Character of Well (Completed as Oil, Gas or Dry Hole): Dry Hole
Date Well Completed 1-17-82
Application for plugging filed _____
Plugging commenced 1-16-82
Plugging completed 10:10 A.M. 1-17-82
Reason for abandonment of well or producing formation Non-commercial production.
Was permission obtained from the Conservation Division or it's Agent's before plugging was commenced? Yes

Name of Conservation Agent who supervised plugging of this well _____
Producing formation None Depth to top _____ bottom _____ T.D. 4,360'
Show depth and thickness of all water, oil and gas formations.

OIL, GAS OR WATER RECORDS

Casing Record

Formation	Content	From	To	Size	Put in	Pulled Out
Mississippi		4362	Sur.	4-1/2"	4362'	2960'

Describe in detail the manner in which the well was plugged, indicating where the mud fluid was placed and the method or methods used in introducing it into the hold. If cement or other plugs were used, state the character of same and depth placed, from _____ feet to _____ feet for each plug set. Cut casing off at 2,960'. Pulled and recovered 76 full joints. Hooked onto 8-5/8" casing w/Howco pumper. Squeezed 8-5/8" with the following:

- 7 sx. gel
- 3 sx. hulls
- 10 sx. gel
- 70 sx. cement (50/50 poz.)
- 7 sx. gel
- 70 sx. cement

RECEIVED
STATE CORPORATION COMMISSION

MAR - 8 1982

Conservation Division
Wichita, Kansas

Plugging completed @ 10:10 A.M. 1-17-82. Squeeze pressure at end of plug 700 psig.
Released rig.

(If additional description is necessary, use BACK of this sheet)

Name of Plugging Contractor _____

STATE OF COLORADO COUNTY OF DENVER, ss.

John R. Kennedy (employee of owner) or (~~owner or operator~~) of the above-described well, being first duly sworn on oath, says: That I have knowledge of the facts, statements, and matters herein contained and the log of the above-described well as filed and that the same are true and correct. So help me God.

(Signature) John R. Kennedy
1616 Glenarm Pl., Suite 2850
Denver, Co. (Address) 80202

SUBSCRIBED AND SWORN TO before me this 3rd day of March, 19 82

My Commission expires: 6-22-83

Notary Public.