


Give All Information Completely  
Make Required Affidavit  
Mail or Deliver Report to:  
Conservation Division  
State Corporation Commission  
212 No. Market  
Wichita, Kansas

WELL PLUGGING RECORD

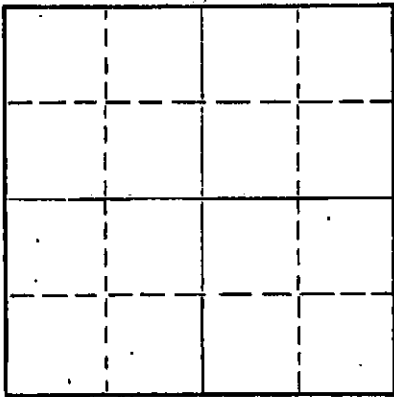

Locate well correctly on above Section Plat

Location as "NE/CNW/SW" or footage from lines C of SWL SWNW 438' x  
 Lease Owner Madal - Gussman  
 Lease Name Myer Well No. #1  
 Office Address Box 14, Great Bend, Kansas  
 Character of Well (completed as Oil, Gas or Dry Hole) \_\_\_\_\_  
 Date well completed \_\_\_\_\_ 19\_\_\_\_  
 Application for plugging filed 9-30-68 19\_\_\_\_  
 Application for plugging approved \_\_\_\_\_ 19\_\_\_\_  
 Plugging commenced 10-2-68 19\_\_\_\_  
 Plugging completed 10-7-68 19\_\_\_\_  
 Reason for abandonment of well or producing formation \_\_\_\_\_

If a producing well is abandoned, date of last production \_\_\_\_\_ 19\_\_\_\_  
 Was permission obtained from the Conservation Division or its agents before plugging was commenced? \_\_\_\_\_

Name of Conservation Agent who supervised plugging of this well Leo Massey  
 Producing formation \_\_\_\_\_ Depth to top \_\_\_\_\_ Bottom \_\_\_\_\_ Total Depth of Well 4388' Feet  
 Show depth and thickness of all water, oil and gas formations.

OIL, GAS OR WATER RECORDS

CASING RECORD

FORMATION	CONTENT	FROM	TO	SIZE	PUT IN	PULLED OUT
				5 1/2"	4380'	2517.09'
				8 5/8"	322'	

Describe in detail the manner in which the well was plugged, indicating where the mud fluid was placed and the method or methods used in introducing it into the hole. If cement or other plugs were used, state the character of same and depth placed, from \_\_\_\_\_ feet to \_\_\_\_\_ feet for each plug set.

Made bottom hole plug back with sand to 4275'. Mixed and ran 5 sacks cement thru dump  
hailer.  
Squeezed hole with 5 sacks hulls, followed with 24 sacks gel, followed with 120 sacks  
cement 6% gel added. Cement from 800' to 300' followed with 6 sacks gel. Gel from  
300' to 40'. Displaced with 10 sacks cement. Cement from 40' to base of cellar.

RECEIVED  
STATE CORPORATION COMMISSION  
OCT 10 1968  
CONSERVATION DIVISION  
Wichita, Kansas


(If additional description is necessary, use BACK of this sheet)

Name of Plugging Contractor Southwest Casing Pulling Co., Inc.  
 Address Box 364, Great Bend, Kansas

STATE OF Kansas, COUNTY OF Barton, ss.  
Southwest Casing Pulling Co. (employee of owner) or (owner or operator) of the above-described well, being first duly sworn on oath, says: That I have knowledge of the facts, statements, and matters herein contained and the log of the above-described well as filed and that the same are true and correct. So help me God.

(Signature) W. C. Spencer Sec.  
Box 364, Great Bend, Kansas  
 (Address)

SUBSCRIBED AND SWORN to before me this 9 day of October, 1968

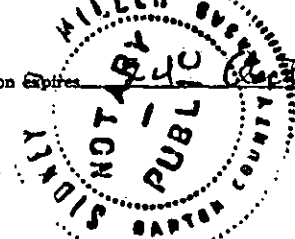My commission expires October 1968  


Sidney D. Miller  
 Notary Public.