

Give All Information Completely
Make Required Affidavit
Mail or Deliver Report to:
Conservation Division
State Corporation Commission
211 No. Broadway
Wichita, Kansas

WELL PLUGGING RECORD

Ness County. Sec. 13 Twp. 17S Rgc. 22 (E) (W) X

Location as "NE/CNW&SW¼" or footage from lines Center of SE NW¼

Lease Owner Jack Shear Oil Field Supplies

Lease Name Kloreno Well No. 1

Office Address 6320 Jacqueline Wichita, Kansas

Character of Well (completed as Oil, Gas or Dry Hole)

Date well completed 19

Application for plugging filed 9-21-64 19

Application for plugging approved 9-22-64 19


Plugging commenced 9-25-64 19

Plugging completed 10-16-64 19

Reason for abandonment of well or producing formation Dry

If a producing well is abandoned, date of last production 19

Was permission obtained from the Conservation Division or its agents before plugging was commenced? Yes

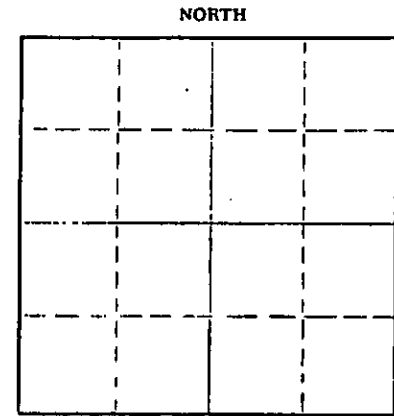

Locate well correctly on above Section Plat

Name of Conservation Agent who supervised plugging of this well Eldon Petty

Producing formation Depth to top Bottom Total Depth of Well 4385 Feet

Show depth and thickness of all water, oil and gas formations.

OIL, GAS OR WATER RECORDS

CASING RECORD

FORMATION	CONTENT	FROM	TO	SIZE	PUT IN	PULLED OUT
				8 5/8	270	None
				5 1/2	None	3519

Describe in detail the manner in which the well was plugged, indicating where the mud fluid was placed and the method or methods used in introducing it into the hole. If cement or other plugs were used, state the character of same and depth placed, from feet to feet for each plug set.

Cleaning out cellar.
Finished cleaning out cellar. Working pipe. Sanded to 4275'. Dumped 4 sacks of cement.
Working pipe. Shot pipe at 3600' & 3500'.
Circulating. Spotted 75 bbl. of oil.
Working pipe. Pulling pipe.
Pulling pipe.
Pulling pipe. Mixing and pumped 20 sacks of mud and 20 sacks of cement at 600'. Dumped 20 sacks of cement at 200'. Capped well with 10 sacks of cement.

RECEIVED
STATE CORPORATION COMMISSION
OCT 21 1964
CONSERVATION DIVISION
Wichita, Kansas

(If additional description is necessary, use BACK of this sheet)

Name of Plugging Contractor Forbes Casing Pulling, Inc.
Address P. O. Box 221 Great Bend, Kansas

STATE OF Kansas, COUNTY OF Barton, ss.
J. O. Forbes (employee of owner) or (owner or operator) of the above-described well, being first duly sworn on oath, says: That I have knowledge of the facts, statements, and matters herein contained and the log of the above-described well as filed and that the same are true and correct. So help me God.

(Signature) J. O. Forbes
P. O. Box 221 Great Bend, Kansas (Address)

SUBSCRIBED AND SWORN TO before me this 20 day of October 19 64

My commission expires May 27, 1965

Notary Public.

15.135-00368-00-00

WELL LOG BUREAU—KANSAS GEOLOGICAL SOCIETY
508 East Murdock, Wichita, Kansas


COPY

Company- PRICKRELL DRILLING COMPANY
Farm- Kleweno No. 1

SEC. 13 T. 17 R. 22W
C SE NW

Total Depth. 4385'
Comm. 2-3-63 Comp. 2-16-63
Shot or Treated.
Contractor.
Issued. 5-18-63

County Ness KANSAS

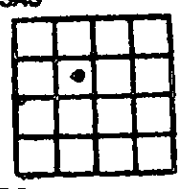

CASING:
5 5/8" 271' cem w/170 sx.
4 1/2" 4382' cem w/100 sx.

Elevation. 2293' RB

Production. 108 BOPD, NW

Figures Indicate Bottom of Formations.

shale & shells	271
shale	460
sand	495
Yellow shale	510
shale	850
red beds	980
sand	1250
red bed & shale	1550
Anhydrite	1585
shale & shells	2200
lime & shale	2310
lime	2385
lime & shale	2535
lime	2855
lime & shale	3730
lime	3825
lime & shale	3590
lime	4110
lime & chert	4135
lime & shale	4270
Chert & Conglomerate	4284
Mississippian	4361
Gilmore City	4385 RTD
Total Depth	
TOPS: 100	
Anhydrite	1550
Heebner	3678
Lansing	3722
Ft. Scott	4185
Conglomerate Chert	4260
Mississippian Osage	4283
Gilmore City	4358

RECEIVED
STATE CORPORATION COMMISSION
OCT 28 1964
CONSERVATION DIVISION
Wichita, Kansas