


WELL PLUGGING RECORD

Give All Information Completely
Make Required Affidavit
Mail or Deliver Report to:
Conservation Division
State Corporation Commission
212 No. Market
Wichita, Kansas

Ness County. Sec. 16 Twp. 16S Rge. 1E/21 (W)
Location as "NE/CNWxSWx" or footage from lines C NE SW
Lease Owner Abercrombie Drilling, Inc. & McClure Oil Co.
Lease Name WIERMAN Well No. 1
Office Address 801 Union Center, Wichita, Kansas
Character of Well (completed as Oil, Gas or Dry Hole) Dry Hole
Date well completed May 23, 19 67
Application for plugging filed (verbally) May 23, 19 67
Application for plugging approved (verbally) May 23, 19 67
Plugging commenced May 23, 19 67
Plugging completed May 23, 19 67
Reason for abandonment of well or producing formation Dry Hole

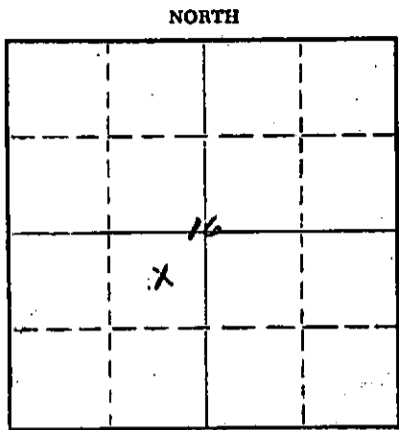

Locate well correctly on above Section Flat

If a producing well is abandoned, date of last production 19
Was permission obtained from the Conservation Division or its agents before plugging was commenced? Yes

Name of Conservation Agent who supervised plugging of this well Leo Massey
Producing formation _____ Depth to top _____ Bottom _____ Total Depth of Well 4345 Feet
Show depth and thickness of all water, oil and gas formations.

OIL, GAS OR WATER RECORDS CASING RECORD

FORMATION	CONTENT	FROM	TO	SIZE	PUT IN	PULLED OUT
				8-5/8"	306'	None

RECEIVED
MAY 29 1967
05-29-1967
CONSERVATION DIVISION

Describe in detail the manner in which the well was plugged, indicating where the mud fluid was placed and the method of methods used in introducing it into the hole. If cement or other plugs were used, state the character of same and depth placed, from _____ feet to _____ feet for each plug set.

First plug was set at 600' with 25 sacks of cement, second plug was at 300' with 20 sacks of cement and 1/4 sack of hulls. The top plug was at 40' with 10 sacks of cement and 1/2 sack of hulls. Two sacks were placed in the rat hole.

(If additional description is necessary, use BACK of this sheet)

Name of Plugging Contractor Vaughan Drilling, Inc.
Address 1618 Wichita Plaza, Wichita, Kansas

STATE OF KANSAS, COUNTY OF SEDGWICK, ss.
Jerry A. Langrehr (employee of owner) or (owner or operator) of the above-described well, being first duly sworn on oath, says: That I have knowledge of the facts, statements, and matters herein contained and the log of the above-described well as filed and that the same are true and correct. So help me God.

(Signature) Jerry A. Langrehr
Jerry A. Langrehr
Abercrombie Drilling, Inc.
801 Union Center (Address)

Subscribed and Sworn to before me this 25th day of May, 19 67

My commission expires March 31, 1970

Margo Dee Montgomery
Margo Dee Montgomery
Notary Public.

WELL LOG

15-135-20030-00-00

COMPANY	ABERCROMBIE DRILLING, INC.
CONTRACTOR	Vaughan Drilling, Inc.
FARM	#1 Wierman
LOCATION	C NE SW of Sec. 16-16-21W Ness County, Kansas
ELEVATION	2349 K.B.
SURFACE PIPE	8 5/8" cemented w/185' sx @ 306'
PRODUCTION	D & A
COMMENCED	5/12/67
COMPLETED	5/23/67

<u>FORMATION</u>	<u>DEPTH</u>	<u>ELECTRIC LOG FORMATION TOPS</u>	
clay & rock	40'	Heebner	3746 (-1397)
shale, shells, & sand	235'	Toronto	3770 (-1421)
shale	590'	Lansing	3790 (-1441)
shale & sand	830'	B/K.C.	4046 (-1697)
shale, shells, & sand	900'	Pawnee	4130 (-1781)
red bed & sand	1060'	B/Pawnee	4199 (-1850)
sand	1327'	Ft. Scott	4218 (-1869)
shale & shells	1527'	Cherokee Sh.	4228 (-1879)
red-bed	1649'	Miss.	4299 (-1950)
Anhydrite	1705'	Log T.D.	4348 (-1999)
shale & lime	3790'		
lime	4115'		
lime & chert	4145'		
lime	4178'		
lime, shale & sand	4207'		
lime	4217'		
lime, shale & sand	4233'		
sand & shale	4262'		
shale, lime, & chert	4295'		
chert & sand	4345'		

RECEIVED
MAY 29 1967
05-29-1967
CONSERVATION DIVISION
Topeka, Kansas

AFFIDAVIT

STATE OF KANSAS
COUNTY OF SEDGWICK

I, Donald D. Vaughan, of the VAUGHAN DRILLING, INC. being first duly sworn on oath, state that I have knowledge of the facts, statements, and matters herein contained and that the same are true and correct.

Donald D. Vaughan
Donald D. Vaughan, President

Subscribed and sworn to before me this 26th day of May, 1967.

Carolyn Sinning
Carolyn Sinning NOTARY

My commission expires March 10, 1971