

CARD MUST BE TYPED

State of Kansas
NOTICE OF INTENTION TO DRILL

CARD MUST BE SIGNED

(see rules on reverse side)

Starting Date: 8 1 84
month day year

API Number 15- 101-21,017-00-00

OPERATOR: License # ... 9726

East

C NW NE ... Sec . 31. Twp . 16 S. Rge . 27. West
(location)

Name ... Gruss Petroleum Management, Inc.

Address ... 900 Building of the Southwest

.. 4620 Ft North from Southeast Corner of Section

City/State/Zip ... Midland, Texas ... 79701

.. 1980 Ft West from Southeast Corner of Section

Contact Person Earl W. Levea

(Note: Locate well on Section Plat on reverse side)

Phone 915. 682-8319

Nearest lease or unit boundary line 660 feet.

CONTRACTOR: License # . 5476

County Lane

Name ... DNB Drilling

Lease Name ... Becker

City/State Wichita, Kansas

Well# . 1

Well Drilled For: Well Class: Type Equipment:

Oil Swd Infield Mud Rotary

Gas Inj Pool Ext. Air Rotary

OWWO Expl Wildcat Cable

Domestic well within 330 feet : yes no

Municipal well within one mile : yes no

If OWWO: old well info as follows:

Operator

Well Name

Comp Date Old Total Depth

Projected Total Depth 4700 feet

Projected Formation at TD ... Mississippian

Expected Producing Formations . Lansing/Kansas City

Depth to Bottom of fresh water 100 feet

Lowest usable water formation Dakota

Depth to Bottom of usable water 1100 feet

Surface pipe by Alternate : 1 2

Surface pipe to be set 375 feet

Conductor pipe if any required None feet

Ground surface elevation +2725 feet MSI.

This Authorization Expires 1/26/85

Approved By *[Signature]* *RC*

I certify that we will comply with K.S.A. 55-101, et seq., plus eventually plugging hole to K.C.C. specifications.

Date ... 7/24/84 ... Signature of Operator or Agent *[Signature]*

Title ... Sr. Engineer

MHC/KDHE 7/26/84


Must be filed with the K.C.C. five (5) days prior to commencing well
This card void if drilling not started within six (6) months of date received by K.C.C.

07-26-1984

Important procedures to follow

1. Notify District office before setting surface casing.
2. Set surface casing by circulating cement to the top.
3. File completion forms ACO-1 with K.C.C. within 90 days of well completion, following instructions on ACO-1, side 1, and including copies of wireline logs.
4. Notify District office 48 hours prior to old well workover or reentry.
5. Prior to plugging, prepare a plugging plan, then obtain agreement from the appropriate district office for an approved plugging plan.
6. Submit plugging report (CP-4) to K.C.C. after plugging is completed.
7. Obtain an approved injection docket number before disposing of salt water.
8. Notify K.C.C. within 10 days when injection commences or terminates.
9. If an alternate 2 completion, cement in the production pipe from below any usable water to surface within 120 days of spud date.

A Regular Section of Land
1 Mile = 5,280 Ft.

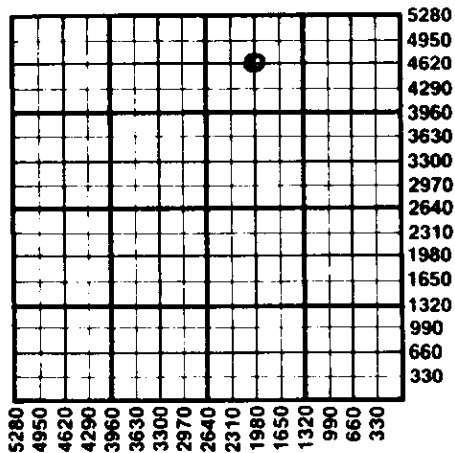

State Corporation Commission of Kansas
Conservation Division
200 Colorado Derby Building
Wichita, Kansas 67202
(316) 263-3238

RECEIVED
STAFF CORPORATION COMMISSION
JUL 26 1984
WICHITA, KANSAS