

Correction card

State of Kansas
NOTICE OF INTENTION TO DRILL
(see rules on reverse side)

CARD MUST BE SIGNED

Starting Date: 11/25/85
month day year

API Number 15- 101-21,256-00-00

OPERATOR: License # 4678
Name LASMO Energy Corporation
Address P.O. Box 1365
City/State/Zip Great Bend, Kansas 67530
Contact Person Claude Blakesley
Phone 316/792-2585

* C. SE. NE/4, Sec 21, Twp 16, S, Rge 27, East West
(location)

3300' Ft North from Southeast Corner of Section
* 660' Ft West from Southeast Corner of Section
(Note: Locate well on Section Plat on reverse side)

CONTRACTOR: License # 5420
Name White and Ellis Drilling
City/State Wichita, Kansas 67202

Nearest lease or unit boundary line 660' feet.
County Lane

Lease Name Broughton Well# 1-21

Domestic well within 330 feet: yes no

Municipal well within one mile: yes no

Well Drilled For: Well Class: Type Equipment:
 Oil Swd Infield Mud Rotary
 Gas Inj Pool Ext. Air Rotary
 OWWO Expl Wildcat Cable

Depth to Bottom of fresh water 75' feet

Lowest usable water formation Dakota

Depth to Bottom of usable water 1050' feet

Surface pipe by Alternate: 1 2

Surface pipe to be set 300' feet

Conductor pipe if any required feet

Ground surface elevation feet MSI

This Authorization Expires 5-19-86

Approved By 11-19-85

I certify that we will comply with K.S.A. 55-101, et seq., plus eventually plugging hole to K.C.C. specifications. fwas SWNE 1980 FEL


Date 11/21/85 Signature of Operator or Agent Claude Blakesley Title Operation Manager

Correction card

Must be filed with the K.C.C. five (5) days prior to commencing well
This card void if drilling not started within six (6) months of date received by K.C.C.

Important procedures to follow:

**A Regular Section of Land
1 Mile = 5,280 Ft.**

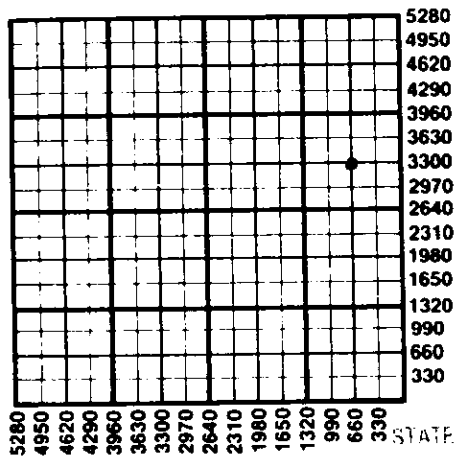

1. Notify District office before setting surface casing.
2. Set surface casing by circulating cement to the top.
3. File completion forms ACO-1 with K.C.C. within 90 days of well completion, following instructions on ACO-1, side 1, and including copies of wireline logs.
4. Notify District office 48 hours prior to old well workover or re-entry.
5. Prior to plugging, prepare a plugging plan, then obtain agreement from the appropriate district office for an approved plugging plan.
6. Submit plugging report (CP-4) to K.C.C. after plugging is completed.
7. Obtain an approved injection docket number before disposing of salt water.
8. Notify K.C.C. within 10 days when injection commences or terminates.
9. If an alternate 2 completion, cement in the production pipe from below any usable water to surface within 120 days of spud date.

RECEIVED
STATE CORPORATION COMMISSION

State Corporation Commission of Kansas
Conservation Division
200 Colorado Derby Building
Wichita, Kansas 67202
(316) 263-3238

NOV 9 1985
11-25-1985
CONSERVATION DIVISION
Wichita, Kansas