

CARD MUST BE TYPED

State of Kansas

CARD MUST BE SIGNED

NOTICE OF INTENTION TO DRILL

(see rules on reverse side)

Starting Date 4. 15. 86.
month day yearAPI Number 15- 101-20,027-00-01
_____ EastOPERATOR: License # 9856
Name D R Well Operators, Inc.
Address 7585 W. Arkansas, Suite B
City/State/Zip .. Lakewood, CO .. 80226
Contact Person .. Patrick N. Swenson
Phone (303) 988-1780NW. NE. NW. Sec. 13. Twp. 16. S. Rg. 27. X West
..... 4950 Ft. from South Line of Section
..... 3630 Ft. from East Line of Section

(Note: Locate well on Section Plat on reverse side)

Nearest lease or unit boundary line 330 feet
County .. Lane ..CONTRACTOR: License # 5302
Name Red Tiger Drilling Co.
City/State .. Wichita, KS .. 67202Lease Name Horchem Well # 1
Ground surface elevation 2663 feet MSLWell Drilled For: Well Class: Type Equipment:
X Oil — SWD — Infield X Mud Rotary
— Gas — Inj — Pool Ext. — Air Rotary
X OWWO — Expl X Wildcat — CableDomestic well within 330 feet: _____ yes X no
Municipal well within one mile: _____ yes X no

If OWWO: old well info as follows:

Operator .. Thunderbird Drlg. & Pet. Res. Fund. Inc.
Well Name Horchem "E" No. 1
Comp Date .. 1/2/72 Old Total Depth .. 4600'Depth to bottom of fresh water .. 300' 1100'
Depth to bottom of usable water .. 1000' 1250'

Surface pipe by Alternate: _____ 1 _____ 2 X

Surface pipe ~~planned~~ set ... 335
Conductor pipe required N/AProjected Total Depth 4600 feet
Formation Mississippi

I certify that well will comply with K.S.A. 55-101, et seq., plus eventually plugging hole to KCC specifications.

Date ... 4/9/86 Signature of Operator or Agent *Samuel A. Sommer* Title ... Vice-President

For KCC Use:

Conductor Pipe Required feet; Minimum Surface Pipe Required 200 feet per Alt. ②

This Authorization Expires .. 4-11-86 Approved By 4-11-86


RCR/KCH

Must be filed with the K.C.C. five (5) days prior to commencing well
This card void if drilling not started within six (6) months of date received by K.C.C.

Important procedures to follow:

1. Notify District office before setting surface casing.
2. Set surface casing by circulating cement to the top.
3. File completion forms ACO-1 with K.C.C. within 90 days of well completion, following instructions on ACO-1, side 1, and including copies of wireline logs.
4. Notify District office 48 hours prior to old well workover or re-entry.
5. Prior to filing Intent, prepare a proposed plugging plan in case well is D & A, then obtain approval of plan when calling district office prior to setting surface pipe.
6. Submit plugging report (CP-4) to K.C.C. after plugging is completed.
7. Obtain an approved injection docket number before disposing of salt water.
8. Notify K.C.C. within 10 days when injection commences or terminates.
9. If an alternate 2 completion, cement in the production pipe from below any usable water to surface within 120 days of spud date.

A Regular Section of Land
1 Mile = 5,280 Ft.

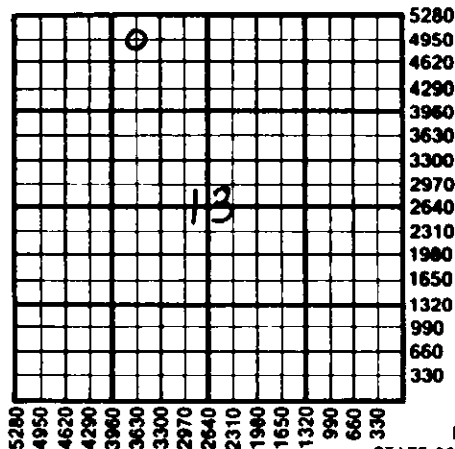

RECEIVED
STATE CORPORATION COMMISSION

APR 11 1986
04-11-1986
CONSERVATION DIVISION
Wichita, Kansas

State Corporation Commission of Kansas
Conservation Division
200 Colorado Derby Building
Wichita, Kansas 67202
(316) 263-3238