


15-101-20878-0000

WELL PLUGGING RECORD

Give All Information Completely
 Make Required Affidavit

COUNTY Lane SEC. 18 TWP. 17S RGE. 28W E/W
 Location as in quarters or footage from lines:
SE/4 NW/4 SE/4 SE NW NW

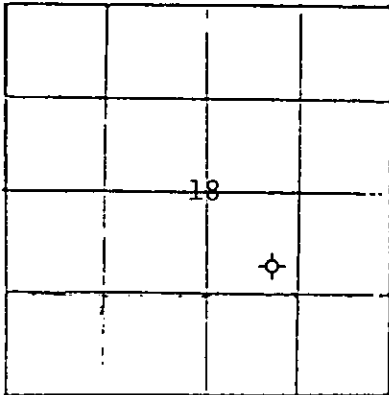

Locate Well
 correctly on above
 Section Plat.

Lease Owner Gear Petroleum Company, Inc.
 Lease Name Fuller Well No. 3-18
 Office Address 300 Sutton Place, Wichita, Kansas 67202
 Character of Well (Completed as Oil, Gas or Dry Hole): Dry Hole
 Date Well Completed December 4, 1983
 Application for plugging filed December 4, 1983
 Plugging commenced December 4, 1983
 Plugging completed December 4, 1983
 Reason for abandonment of well or producing formation D & A

Was permission obtained from the Conservation Division or it's
 Agent's before plugging was commenced? yes (DL)

Name of Conservation Agent who supervised plugging of this well Robert Tarbutton

Producing formation _____ Depth to top _____ bottom _____ T.D. 4,635'

Show depth and thickness of all water, oil and gas formations.

OIL, GAS OR WATER RECORDS

Casing Record

Formation	Content	From	To	Size	Put in	Pulled Out
				8 5/8"	334'	-0-

Describe in detail the manner in which the well was plugged, indicating where the mud
 fluid was placed and the method or methods used in introducing it into the hold. If cement
 or other plugs were used, state the character of same and depth placed, from _____ feet
 to _____ feet for each plug set.

- 1st Plug @ 2160' w/60 sx cement
- 2nd Plug @ 1620' w/50 sx cement
- 3rd Plug @ 660' w/70 sx cement
- 4th Plug @ 40' w/10 sx cement
- 15 sx cement in rathole
- 60/40 Pozmix, 2% Gel, 3% C.C.


DEC 14 1983
 12-14-83
 STATE CORP. COM.
 WICHITA, KANSAS

(If additional description is necessary, use BACK of this sheet)

Name of Plugging Contractor Sun Oil Well Cementing

STATE OF Kansas COUNTY OF Sedgwick, ss.

Jim Thatcher, Drilling & Production Mgr (employee of owner) or (owner or operator) of the
 above-described well, being first duly sworn on oath, says: That I have knowledge of the
 facts, statements, and matters herein contained and the log of the above-described well as
 filed and that the same are true and correct. So help me God.

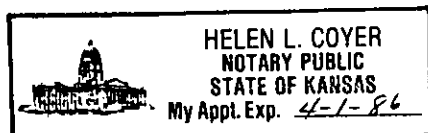

(Signature) Jim Thatcher
300 SUTTON PLACE, WICHITA KS 67202
 (Address)

SUBSCRIBED AND SWORN TO before me this 13th day of December, 19 83

Helen L. Coyer
 Helen L. Coyer Notary Public.

My Commission expires: April 1, 1986