

STATE OF KANSAS
STATE CORPORATION COMMISSION


15-101-20342-0000

WELL PLUGGING RECORD

Give All Information Completely
Make Required Affidavit
Mail or Deliver Report to
Conservation Division
State Corporation Comm.
245 North Water
Wichita, KS 67202

Lane _____ County. Sec. 18 Twp. 17S Rge. 28 E/W
Location as "NE/CNW/SW" or footage from lines _____
SW SE NE

Lease Owner Mull-Drilling Co.
Lease Name Fuller "A" Well No. 1
Office Address 221 N. Main Suite 300 Wichita, Ks 67202
Character of Well (Completed as Oil, Gas or Dry Hole) _____
Dry Hole

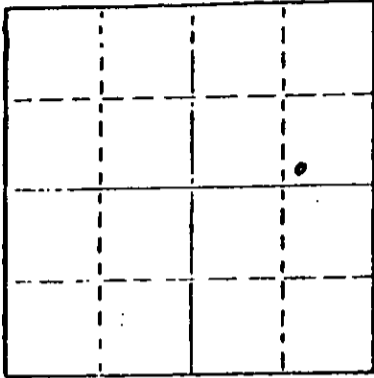

Locate well correctly on above
Section Plat

Date Well completed 10-18-78
Application for plugging filed 10-18-78
Application for plugging approved 10-18-78
Plugging commenced 10-18-78
Plugging completed 10-18-78

Reason for abandonment of well or producing formation _____
Dry Hole
If a producing well is abandoned, date of last production 19 _____

Was permission obtained from the Conservation Division or
its agents before plugging was commenced? Yes

Name of Conservation Agent who supervised plugging of this well Gilbert Bolthazor
Producing formation _____ Depth to top _____ Bottom _____ Total Depth of Well _____
Show depth and thickness of all water, oil and gas formations.

OIL, GAS OR WATER RECORDS

CASING RECORD

FORMATION	CONTENT	FROM	TO	SIZE	PUT IN	PULLED OUT
Surface Pipe		0'	330'	8 5/8"	317.88'	

Describe in detail the manner in which the well was plugged, indicating where the mud fluid was placed and the method or methods used in introducing it into the hold. If cement or other plugs were used, state the character of same and depth placed, from _____ feet to _____ feet for each plug set.

#1 Plug set @ 850' with 70 sacks cement.

#2 Plug set @ 300' with 20 sacks cement.

#3 Plug set @ 40' with 10 sacks cement.

RECEIVED
OCT 24 1978
10-24-78

(If additional description is necessary, use BACK of this sheet)

Name of Plugging Contractor Blue Goose Drilling Co., Inc.


STATE OF Kansas COUNTY OF Barton ss.
George E. Miller, Jr. (employee of owner) or (owner or operator) of the above-described

well, being first duly sworn on oath, says: That I have knowledge of the facts, statements, and matters herein contained and the log of the above-described well as filed and that the same are true and correct. So help me God.

(Signature) George E. Miller, Jr.
P.O. Box 1413, Great Bend, Kansas 67530
(Address)

Subscribed and Sworn to before me this 23rd day of October, 1978

My commission expires 8-1-81
Mary Ann Schwamborn Notary Public.

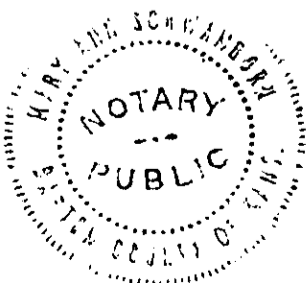

15701-20342-0000

WELL LOG
Fuller A #1
SW SE NE Sec.18-17S-28W
Lane County, Kansas

Name of Operator: Mull Drilling Co.
221 N. Main, Suite 300
Wichita, Kansas 67202

Date Completed: October 18, 1978

FROM	TO	
0	100	Shale
100	150	Sand
150	330	Shale
330	2160	Shale & Sand
2160	2168	Shale & Shells
2168	2200	Anhydrite
2200	2653	Shale & Shells
2653	2910	Shale
2910	3280	Shale & Shells
3280	3428	Lime & Shale
3428	3630	Shale & Shells
3630	3992	Lime & Shale
3992	4073	Lime
4073	4085	Lime & Shale
4085	4187	Lime
4187	4310	Lime & Shale
4310	4405	Lime
4405	4542	Lime & Shale
4542	4552	Lime
4552	4585	Zinc & Shale
4585		Total Depth

RECEIVED
STATE CORPORATION COMMISSION
OCT 24 1978
CORPORATION DIVISION

STATE OF KANSAS

COUNTY OF BARTON ss

George E. Miller, Jr., President of Blue Goose Drilling Co., Inc.
being first duly sworn on oath says: That I have knowledge of the facts,
statements and matters herein contained and the log of the above described well
as filed and that the same are true and correct.

George E. Miller, Jr.
George E. Miller, Jr.

Subscribed and sworn before me this 23rd day of October, 1978.

Mary Ann Schwaborn
Notary Public Barton County

My Commission Expires 8-1-81

