


15-169-00833-00-00

Give All Information Completely  
Make Required Affidavit  
Mail or Deliver Report to:  
Conservation Division  
State Corporation Commission  
211 No. Broadway  
Wichita, Kansas

WELL PLUGGING RECORD

Saline County, Sec. 32 Twp. 15 Rge. 3 (E) W

Location as "NE/CNWxSWx" or footage from lines. NE NE SW  
Lease Owner Frank J. Black  
Lease Name Nelson Well No. 2  
Office Address 600 Washington, McPherson Kansas  
Character of Well (completed as Oil, Gas or Dry Hole) Oil well  
Date well completed 9-18- 19 53  
Application for plugging filed 8-8 19 57  
Application for plugging approved 8-10 19 57  
Plugging commenced 8-16 19 57  
Plugging completed 8-20 19 57  
Reason for abandonment of well or producing formation Non-Commercial

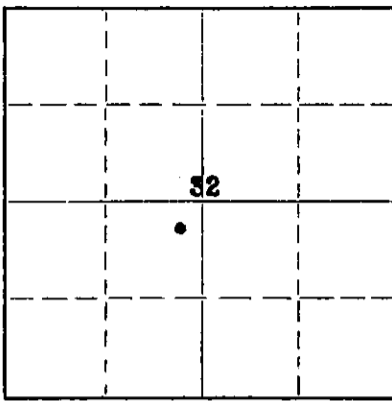

Locate well correctly on above Section Plat

If a producing well is abandoned, date of last production NOT KNOWN 19       
Was permission obtained from the Conservation Division or its agents before plugging was commenced? Yes

Name of Conservation Agent who supervised plugging of this well Ruel Durkes  
Producing formation Maquoketa Depth to top 3398 Bottom 3401 Total Depth of Well 3401 Feet  
Show depth and thickness of all water, oil and gas formations.

OIL, GAS OR WATER RECORDS

CASING RECORD

| FORMATION | CONTENT | FROM | TO | SIZE   | PUT IN | PULLED OUT |
|-----------|---------|------|----|--------|--------|------------|
|           |         |      |    | 8 5/8" | 360    | None       |
|           |         |      |    | 5 1/2" | 3398   | 2926'      |
|           |         |      |    |        |        |            |
|           |         |      |    |        |        |            |
|           |         |      |    |        |        |            |
|           |         |      |    |        |        |            |

Describe in detail the manner in which the well was plugged, indicating where the mud fluid was placed and the method or methods used in introducing it into the hole. If cement or other plugs were used, state the character of same and depth placed, from \_\_\_\_\_ feet to \_\_\_\_\_ feet for each plug set.

Dumped 6 sack plug in bottom 3401 to 3380'

Shot 5 1/2" casing loose at 2926' and pulled same

Mudded hole

Set rock bridge at 200' & Dumped 15 sax cement on same

Mudded hole

Set rock bridge at 20'

Dumped 5 sack cem. plug from 20' to bottom of cellar. Job Completed.

STATE OF KANSAS  
SEP 17 1957  
CONSERVATION DIVISION

(If additional description is necessary, use BACK of this sheet)  
Name of Plugging Contractor Wiggins & Lamb Pipe Pulling Co.  
Address P.O. Box 191, McPherson Kansas

STATE OF Kansas COUNTY OF McPherson ss.  
\_\_\_\_\_  
(employee of owner) or (owner or operator) of the above-described well, being first duly sworn on oath, says: That I have knowledge of the facts, statements, and matters herein contained and the log of the above-described well as filed and that the same are true and correct. So help me God.  
(Signature) Frank J. Black

SUBSCRIBED AND SWORN TO before me this 10 day of Sept, 19 57  
Frank Nelson  
Notary Public.

My commission expires Jan 10-1961

PLUGGING  
FILE SEC 32 T 15 R 3W  
BOOK PAGE 34 LINE 35

15-169-00833-00-00


WELL LOG BUREAU—KANSAS GEOLOGICAL SOCIETY  
503 East Murdock, Wichita, Kansas

Company- CURRIER & KEYES  
Farm- Nelson No. 2

SEC. 32 T. 15 R. 3W  
NE NE SW

Total Depth. 3401  
Comm. 9-7-53 Comp. 9-18-53  
Shot or Treated.  
Contractor. Sterling Drilling Company  
Issued. 10-24-53

County Saline  
KANSAS

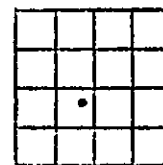

Elevation. 1309

Production. Pump. 30 BO & NW

Figures indicate Bottom of Formations.

|              |       |      |
|--------------|-------|------|
| shale        | 50 to | 325  |
| lime         |       | 465  |
| lime & shale |       | 615  |
| lime         |       | 800  |
| lime & shale |       | 860  |
| shale        |       | 1025 |
| lime & shale |       | 1265 |
| shale        |       | 1700 |
| lime         |       | 2010 |
| lime & shale |       | 2325 |
| lime         |       | 2705 |
| lime & shale |       | 2825 |
| shale        |       | 2855 |
| lime         |       | 3150 |
| lime & shale |       | 3215 |
| shale        |       | 3385 |
| lime         |       | 3401 |
| Total depth  |       |      |

|                    |      |
|--------------------|------|
| Scout Tops:        |      |
| Mississippi        | 2855 |
| Meisner            | 3320 |
| Hunton             | 3321 |
| Maquoketa shale    | 3338 |
| Maquoketa dolomite | 3397 |

|           |                |
|-----------|----------------|
| PLUGGING  |                |
| FILE SEC  | 32 T. 15 R. 3W |
| BOOK PAGE | 34 LINE 35     |

ST  
AUG 9  
FORM 100