


15-101-20452-00-00

STATE OF KANSAS
STATE CORPORATION COMMISSION

Form CP-4

WELL PLUGGING RECORD

Give All Information Completely
Make Required Affidavit
Mail or Deliver Report to:
Conservation Division
State Corporation Commission
P. O. Box 17027
Wichita, Kansas 67217
NORTH

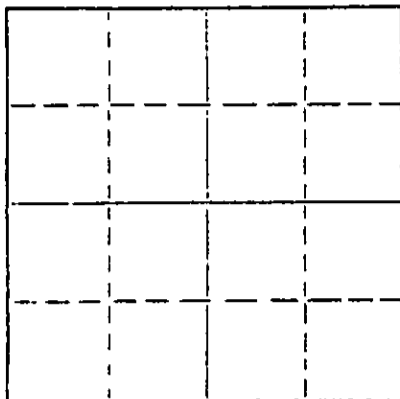

Locate well correctly on above
Section Plat

LANE County, Sec 4 Twp 16S Rge 27W (E) (W)
Location as "NE/CNW/SW" or footage from lines NE NE SE
Lease Owner DONALD C. SLAWSON
Lease Name Lang 'D' Well No. 1
Office Address 200 Douglas Building Wichita, KS 67202
Character of Well (completed as Oil, Gas or Dry Hole) DRY HOLE
Date well completed May 15, 1980
Application for plugging filed May 15, 1980
Application for plugging approved May 15, 1980
Plugging commenced May 15, 1980
Plugging completed May 15, 1980
Reason for abandonment of well or producing formation Dry Hole

If a producing well is abandoned, date of last production 19
Was permission obtained from the Conservation Division or its agents before plugging was commenced? Yes

Name of Conservation Agent who supervised plugging of this well Gilbert Balthazor
Producing formation Depth to top Bottom Total Depth of Well 4590 Feet
Show depth and thickness of all water, oil and gas formations.

OIL, GAS OR WATER RECORDS

CASING RECORD

FORMATION	CONTENT	FROM	TO	SIZE	PUT IN	PULLED OUT
	362.20'	surface	381'	8 5/8"		

Describe in detail the manner in which the well was plugged, indicating where the mud fluid was placed and the method or methods used in introducing it into the hole. If cement or other plugs were used, state the character of same and depth placed, from feet to feet for each plug set.

1st plug @ 800' w/60 sx
2nd plug @ 360' w/30 sx
Solid Bridge @ 40' w/10 sx
5 sx in Rat Hole

RECEIVED
STATE CORPORATION COMMISSION
JUL 18 1980
07-18-1980
CONSERVATION DIVISION
Wichita, Kansas

(If additional description is necessary, use BACK of this sheet)
Name of Plugging Contractor SLAWSON DRILLING CO., INC.
Address 200 Douglas Building Wichita, Kansas 67202

STATE OF KANSAS COUNTY OF SEDGWICK ss.
JAMES C. REMSBERG (employee of owner) or (owner or operator) of the above-described well, being first duly sworn on oath, says: That I have knowledge of the facts, statements, and matters herein contained and the log of the above-described well as filed and that the same are true and correct. So help me God.

(Signature) James C. Remsberg
JAMES C. REMSBERG
200 Douglas Building Wichita, Kansas 67202
(Address)

Subscribed and sworn to before me this 14th day of July 1980

Sherry L. Kendall
SHERRY L. KENDALL Notary Public.

My commission expires 6/12/82



15-101-20452-00-00

WELL LOG

OPERATOR: DONALD C. SLAWSON
 200 DOUGLAS BUILDING
 WICHITA, KANSAS 67202

LEASE: #1 Lang 'D'
 NE NE SE Sec. 4-16-27W
 Lane County, Kansas

CONTRACTOR: SLAWSON DRILLING COMPANY, INC.
 200 DOUGLAS BUILDING
 WICHITA, KANSAS 67202

COMMENCED: May 5, 1980

COMPLETED: May 15, 1980

CASING: Surface - set 8 5/8" @ 381' w/275 sx 60/40 poz

0 - 383 Shale
 383 - 1430 Shale and shells
 1430 - 2272 Shale and sand
 2272 - 2986 Shale
 2986 - 3940 Lime and shale
 3940 - 4590 Lime
 4590 RTD

RECEIVED
 STATE CORPORATION COMMISSION
 JUL 18 1980
 07-18-1980
 CONSERVATION DIVISION
 Wichita, Kansas

STATE OF KANSAS)
)
 COUNTY OF SEDGWICK) SS.

I, JAMES C. REMSBERG, OF THE SLAWSON DRILLING COMPANY, INC.
 UPON OATH STATE THAT THE ABOVE AND FOREGOING IS A TRUE AND CORRECT COPY OF THE
 LOG OF THE #1 Lang 'D' TEST.

James C. Remsberg

 JAMES C. REMSBERG, Engineer

SUBSCRIBED AND SWORN TO BEFORE ME THIS 14th DAY OF July, 1980.

Sherry L. Kendall

 SHERRY L. KENDALL, Notary Public

MY COMMISSION EXPIRES: 6/12/82

