


STATE OF KANSAS  
STATE CORPORATION COMMISSION

WELL PLUGGING RECORD

Give All Information Completely  
Make Required Affidavit  
Mail or Deliver Report to  
Conservation Division  
State Corporation Comm.  
245 North Water  
Wichita, KS 67202

Lane \_\_\_\_\_ County. Sec. 36 Twp. 16 Rge. 27w E/W  
Location as "NE/CNW $\frac{1}{4}$ SW $\frac{1}{4}$ " or footage from lines \_\_\_\_\_  
SW-SW-NW

Lease Owner Montgomery Drilling Program # 2  
Lease Name Little Blue Well No. 1  
Office Address 235 Montgomery St. San Francisco, Calif. 94104  
Character of Well (Completed as Oil, Gas or Dry Hole) \_\_\_\_\_  
Dry Hole

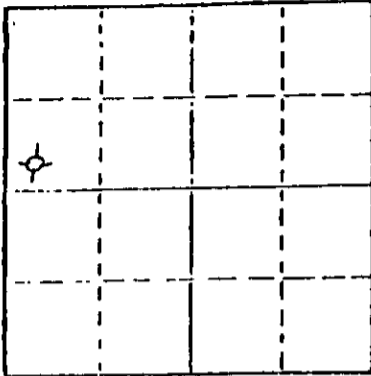

Locate well correctly on above  
Section Plat

Date Well completed Nov. 13 1978  
Application for plugging filed Nov. 13 1978  
Application for plugging approved Nov. 13 1978  
Plugging commenced Nov. 13 1978  
Plugging completed Nov. 13 1978  
Reason for abandonment of well or producing formation \_\_\_\_\_

Dry hole  
If a producing well is abandoned, date of last production \_\_\_\_\_  
19\_\_\_\_

Was permission obtained from the Conservation Division or  
its agents before plugging was commenced? Yes

Name of Conservation Agent who supervised plugging of this well Gilbert Balitzor  
Producing formation \_\_\_\_\_ Depth to top \_\_\_\_\_ Bottom \_\_\_\_\_ Total Depth of Well 4590'  
Show depth and thickness of all water, oil and gas formations.

OIL, GAS OR WATER RECORDS

CASING RECORD

FORMATION	CONTENT	FROM	TO	SIZE	PUT IN	PULLED OUT
Surface		0'	256'	8 5/8"	256'	0'

Describe in detail the manner in which the well was plugged, indicating where the mud fluid  
was placed and the method or methods used in introducing it into the hold. If cement or other  
plugs were used, state the character of same and depth placed, from \_\_\_\_\_ feet to  
\_\_\_\_\_ feet for each plug set.

- 1st. plug at 750' with 70 sacks 50-50 Poz. 6% Gel.
- 2nd. plug at 240' with 20 sacks 50-50 Poz. 6% Gel.
- 3rd. plug at 40' with 10 sacks 50-50 Poz. 6% Gel.

RECEIVED  
STATE CORPORATION COMMISSION  
11-13-1978  
12-06-1978  
CONSERVATION DIVISION  
Wichita, Kansas

(If additional description is necessary, use BACK of this sheet)

Name of Plugging Contractor Allied Cementing Co., Inc.

STATE OF Kansas COUNTY OF Graham, ss.  
Jerry M. Helberg (employee of owner) or (owner or operator)  
of the above-described well, being first duly sworn on oath, says: That I have knowledge of  
the facts, statements, and matters herein contained and the log of the above-described well  
as filed and that the same are true and correct. So help me God.

(Signature) Jerry M. Helberg  
Box 32 Morland, Kansas 67650  
(Address)

SUBSCRIBED AND SWORN TO before me this 30th day of Nov., 19 78

My commission expires Dec. 4, 1979  
Janice Richman Notary Public.



15-101-20349-00-00

DRILLERS LOG

LITTLE BLUE #1

CASING RECORD:  
8 5/8" set at 256'

OPERATOR: Montgomery Drilling Program  
#2 % Zachary Dean

CONTRACTOR: Helberg Oil Company

TOTAL DEPTH:  
4590'

COMMENCED: November 1, 1978

COMPLETED: November 13, 1978

DESCRIPTION:

SW SW NW  
Sec. 36-16-27, Lane County, Kansas

FORMATION	FROM	TO	REMARKS
Sand & Shale	0	270	
Shale	270	1090	
Shale & Sand	1090	1458	
Shale	1458	2014	
Shale	2014	2136	
Shale	2136	2253	
Shale	2253	2430	
Shale	2430	2611	
Shale	2611	2795	
Shale	2795	2923	
Shale	2923	3022	
Shale	3022	3151	
Shale	3151	3245	
Shale	3245	3299	
Shale	3299	3372	
Shale	3372	3482	
Shale	3482	3577	
Shale	3577	3652	
Shale	3652	3787	
Shale & Lime	3787	3911	
Shale & Lime	3911	3975	
Shale & Lime	3975	4015	
Shale & Lime	4015	4076	
Lime	4076	4142	
Lime	4142	4215	
Lime & Shale	4215	4288	
Lime	4288	4342	
Lime	4342	4393	
Lime	4393	4429	
Lime	4429	4475	
Lime	4475	4485	
Lime	4485	4531	
Lime & Shale	4531	4590	
T.D.	4590		D & A

RECEIVED  
STATE GEOLOGICAL SURVEY  
12-06-1978  
CONSERVATION DIVISION  
Topeka, Kansas

I certify that the above is a true and correct copy of the log to the best of my knowledge.

HELBERG OIL COMPANY

*Jerry M. Helberg*  
Jerry M. Helberg

Subscribed and sworn to before me this 16th day of November, 1978.

*Janice Liberman*  
Notary Public

*My Commission Expires Dec. 4, 1979*