


Give All Information Completely
Make Required Affidavit
Mail or Deliver Report to:
Conservation Division
State Corporation Commission
211 No. Broadway
Wichita, Kansas

WELL PLUGGING RECORD

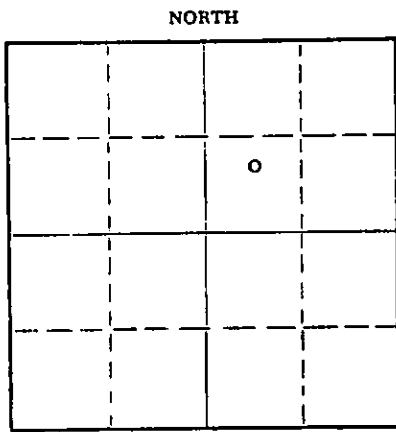

Locate well correctly on above Section Plat

Lane _____ County. Sec. 30 Twp. 16S Rge. 27W (E) _____ (W) _____
Location as "NE/CNWxSWx" or footage from lines 150' N. of SW NE
Lease Owner B-K-R c/o W. F. Roland
Lease Name Gregor Well No. 2
Office Address 52 D. Lake, Pueblo, Colorado
Character of Well (completed as Oil, Gas or Dry Hole) Dry Hole
Date well completed November 11 1964
Application for plugging filed November 11 1964
Application for plugging approved November 11 1964
Plugging commenced November 11 1964
Plugging completed November 11 1964
Reason for abandonment of well or producing formation Dry Hole

If a producing well is abandoned, date of last production _____ 19____
Was permission obtained from the Conservation Division or its agents before plugging was commenced? _____

Name of Conservation Agent who supervised plugging of this well W. L. Nichols, Moreland, Kansas
Producing formation _____ Depth to top _____ Bottom _____ Total Depth of Well 4663 Feet
Show depth and thickness of all water, oil and gas formations.

OIL, GAS OR WATER RECORDS

CASING RECORD

FORMATION	CONTENT	FROM	TO	SIZE	PUT IN	PULLED OUT
		0	250'	8 5/8"	250'	None

Describe in detail the manner in which the well was plugged, indicating where the mud fluid was placed and the method or methods used in introducing it into the hole. If cement or other plugs were used, state the character of same and depth placed, from _____ feet to _____ feet for each plug set.

Set Plug @ 600'/20 sacks cement
240'/20 sacks cement
40'/10 sacks cement

12-04-1964

(If additional description is necessary, use BACK of this sheet)

Name of Plugging Contractor Hellar Drilling Company, Inc.
Address 1014 Union Center, Wichita, Kansas

STATE OF Kansas, COUNTY OF Sedgwick, ss.
D. L. Hellar, Pres. of Hellar Drilg. Co. (employee of owner) or (owner or operator) of the above-described well, being first duly sworn on oath, says: That I have knowledge of the facts, statements, and matters herein contained and the log of the above-described well as filed and that the same are true and correct. So help me God.

(Signature) [Signature] D. L. Hellar, President
1014 Union Center, Wichita, Kansas
(Address)

SUBSCRIBED AND SWORN TO before me this 2nd day of December, 1964

My commission expires March 25, 1968. Catherine Darcey Notary Public.

15-101-19008-00-00

DRILLER'S LOG

COMPANY: B - K - R c/o W. F. Roland
 CONTRACTOR: Hellar Drilling Company, Inc.
 LEASE: #2 Gregor
 LOCATION: 150' N. of SW NE 30-16S-27W, Lane County, Ks.
 COMMENCED: October 31, 1964
 COMPLETED: November 11, 1964
 CASING: Set 8 5/8" surface casing @ 250'/175 sacks cement

0-250	Sand-shale-shells
250-350	Shale
350-1304	Shale & shells-Red Beds
1304-1589	Shale & shells
1589-1620	Blaine-Anhydrite
1620-1820	Shale & sand
1820-2164	Sand, shale & shells
2164-2197	Anhydrite
2197-2252	Lime & shale
2252-2755	Shale & Lime
2755-2912	Lime & shale
2912-3040	Shale & lime
3040-3267	Ft. Riley
3267-3397	Lime & shale
3397-3645	Shale & Lime
3645-3745	Lime & shale
3745-3859	Shale & chalky lime
3859-3976	Shale, Lime, chalk
3976-4060	Shale & K. C. Lime
4060-4212	Lsg. K. C.
4212-4250	K. C. Lime
4250-4375	Lime
4375-4424	Lime & shale
4424-4456	Lime
4456-4495	Lime & shale
4495-4656	Lime
4656-4663	Miss. Lime
4663	Rotary Total Depth D & A

DEC 21 1964
 12-04-1964
 CONSERVATION DIVISION
 STATE OF KANSAS

STATE OF KANSAS)
) SS
 COUNTY OF SEDGWICK)

I, D. L. Hellar, do hereby certify that the above and foregoing is a true and correct copy of the log of the #2 Gregor, located 150' N. of SW NE 30-16S-27W, Lane County, Kansas, as reflected by the files of the Hellar Drilling Company, Inc.

HELLAR DRILLING COMPANY, INC.

By *D. L. Hellar*
 President - D. L. Hellar

Subscribed and sworn to before me, a Notary Public, in and for Sedgwick County, Kansas, this 2nd day of December, 1964.

My Commission Expires:
 March 25, 1968.

Catherine Darcey
 Notary Public - Catherine Darcey