


15-101-00072-00-00

Give All Information Completely  
Make Required Affidavit  
Mail or Deliver Report to:  
Conservation Division  
State Corporation Commission  
211 No. Broadway  
Wichita, Kansas

WELL PLUGGING RECORD

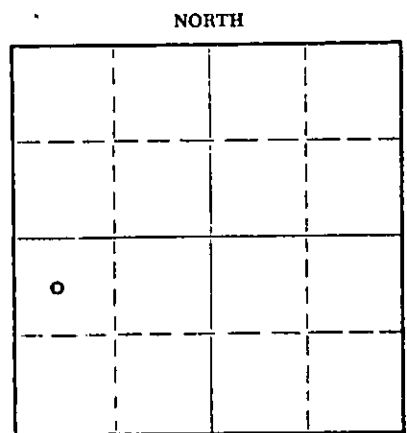

Lane \_\_\_\_\_ County. Sec. 30 Twp. 16S Rge. 27W (E) \_\_\_\_\_ W (W) \_\_\_\_\_  
Location as "NE/CNW/SW" or footage from lines c NW SW  
Lease Owner B-K-R  
Lease Name Hanks Well No. 1  
Office Address c/o W. F. Roland, 52 Drake, Pueblo, Colorado  
Character of Well (completed as Oil, Gas or Dry Hole) Dry Hole  
Date well completed June 12 19 63  
Application for plugging filed June 12 19 63  
Application for plugging approved June 12 19 63  
Plugging commenced June 12 19 63  
Plugging completed June 12 19 63  
Reason for abandonment of well or producing formation Dry Hole

If a producing well is abandoned, date of last production \_\_\_\_\_ 19 \_\_\_\_\_  
Was permission obtained from the Conservation Division or its agents before plugging was commenced? Yes

Name of Conservation Agent who supervised plugging of this well W. L. Nichols, Moreland, Kansas  
Producing formation \_\_\_\_\_ Depth to top \_\_\_\_\_ Bottom \_\_\_\_\_ Total Depth of Well \_\_\_\_\_ Feet  
Show depth and thickness of all water, oil and gas formations.

OIL, GAS OR WATER RECORDS

CASING RECORD

FORMATION	CONTENT	FROM	TO	SIZE	PUT IN	PULLED OUT
		0	267'	8 5/8"	267'	none

Describe in detail the manner in which the well was plugged, indicating where the mud fluid was placed and the method or methods used in introducing it into the hole. If cement or other plugs were used, state the character of same and depth placed, from \_\_\_\_\_ feet to \_\_\_\_\_ feet for each plug set.

Set Plug @ 600' 20 sacks cement  
Plug @ 250' 20 sacks cement  
Plug @ 35' 10 sacks cement

**RECEIVED**  
STATE CORPORATION COMMISSION  
JUN 24 1963  
06-24-1963  
CONSERVATION DIVISION  
Wichita, Kansas

(If additional description is necessary, use BACK of this sheet)  
Name of Plugging Contractor Hellar Drilling Company, Inc.  
Address 1014 Union Center, Wichita, Kansas

STATE OF Kansas COUNTY OF S<sup>E</sup>dgwick, ss.  
D. L. Hellar, Pres. of Hellar Drlg. Co. Inc. (employee of owner) or (owner or operator) of the above-described well, being first duly sworn on oath, says: That I have knowledge of the facts, statements, and matters herein contained and the log of the above-described well as filed and that the same are true and correct. So help me God.  
(Signature) [Signature] D. L. Hellar, President  
1014 Union Center, Wichita 2, Kansas  
(Address)

SUBSCRIBED AND SWORN TO before me this 24th day of June, 19 63

My commission expires March 25, 1964.  
Catherine Darcey Notary Public.



15-101-00072-00-00

DRILLER'S LOG

COMPANY:	B - K - R
CONTRACTOR:	Hellar Drilling Company, Inc.
LEASE:	#1 Hanks
LOCATION:	c NW SW Sec. 30-16S-27W, Lane County, Kansas
COMMENCED:	June 1, 1963
COMPLETED:	June 12, 1963
CASING:	Set 8 5/8" surface casing @ 267' / 225 sacks cement

0-30	Clay
30-267	Sand & Shale
267-410	Shale
410-1310	Shale & Sand & Shells
1310-1602	Shale & Shells
1602-1629	Anhydrite
1629-1736	Shale & Shells
1736-1960	Sand
1960-2650	Shale & Shells
2650-2785	Shale & Lime
2785-2915	Lime & Shale
2915-3139	Lime
3139-3274	Lime & Shale
3274-3370	Ft. Riley Section
3370-3670	Lime & Shale
3670-3901	Shale & Lime
3901-4005	Lime - chalky
4005-4075	Lime
4075-4104	Lime & Chert
4104-4503	Lime
4503-4563	Lime & Shale
4563-4624	Lime
4624-4633	Lime & Chert
4633-4651	Lime
4651-4680	Mississippian
4680	Rotary Total Depth

**RECEIVED**  
STATE CORPORATION COMMISSION

JUN 24 1963  
06-24-1963  
CONSERVATION DIVISION  
Wichita, Kansas

STATE OF KANSAS )  
                          ) SS  
COUNTY OF SEDGWICK )

I, D. L. Hellar, do hereby certify that the above and foregoing is a true and correct copy of the log of the #1 Hanks, located in c. NW SW Sec. 30-16S-27W, Lane County, Kansas, as reflected by the files of the Hellar Drilling Company, Inc.

HELLAR DRILLING COMPANY, INC.

By D. L. Hellar  
President D. L. Hellar

Subscribed and sworn to before me, a Notary Public, in and for Sedgwick County, Kansas, this 24th day of June, 1963.

My Commission Expires:  
March 25, 1964.

Catherine Darcy  
Notary Public - Catherine Darcy