


15-101-20697-00-00

WELL PLUGGING RECORD

Give All Information Completely
 Make Required Affidavit

COUNTY _____ Lane _____ SEC. 30 TWP. 16S RGE. 27W ~~NE~~W
 Location as in quarters or footage from lines:
 NW NW SE

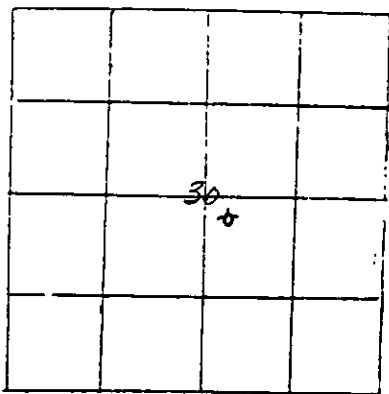

Locate Well
 correctly on above
 Section Platt.

Lease Owner DONALD C. SLAWSON (AGIP)
 Lease Name Hanks 'H' Well No. 2
 Office Address 200 Douglas Building Wichita, Kansas 67202
 Character of Well (Completed as Oil, Gas or Dry Hole): Dry Hole
 Date Well Completed August 14, 1982
 Application for plugging filed Yes
 Plugging commenced August 14, 1982
 Plugging completed August 14, 1982
 Reason for abandonment of well or producing formation Dry Hole

Was permission obtained from the Conservation Division or it's
 Agent's before plugging was commenced? Yes

Name of Conservation Agent who supervised plugging of this well Steve Durrant

Producing formation _____ Depth to top _____ bottom _____ T.D. 4670'

Show depth and thickness of all water, oil and gas formations.

OIL, GAS OR WATER RECORDS

Casing Record

Formation	Content	From	To	Size	Put in	Pulled Out
		surface	291'	8 5/8"		

Describe in detail the manner in which the well was plugged, indicating where the mud
 fluid was placed and the method or methods used in introducing it into the hold. If cement
 or other plugs were used, state the character of same and depth placed, from _____ feet
 to _____ feet for each plug set.

1st plug @ 1020' w/70 sx
 2nd plug @ 300' w/40 sx
 Bridge @ 40' w/10 sx
 10 sx in Rat Hole


(If additional description is necessary, use BACK of this sheet)

Name of Plugging Contractor Halliburton Services
Box 579 Great Bend, Kansas 67530

STATE OF KANSAS COUNTY OF SEDGWICK, ss.

William R. Horigan (employee of owner) or (owner or operator) of the
 above-described well, being first duly sworn on oath, says: That I have knowledge of the
 facts, statements, and matters herein contained and the log of the above-described well as
 filed and that the same are true and correct. So help me God.

(Signature) William R. Horigan
William R. Horigan 200 Douglas Building
 (Address) Wichita, KS 67202

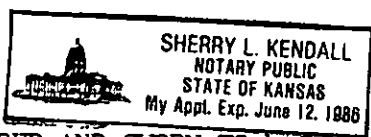

SUBSCRIBED AND SWORN TO before me this 10th day of November, 1982

My Commission expires: 06/12/86

Sherry L. Kendall
 Sherry L. Kendall
 STATE OF KANSAS
 NOTARY PUBLIC
 My Commission Expires June 12, 1986

RECEIVED
 NOV 24 1982
 CONSERVATION DIVISION
 Wichita Kansas