

15-095-20480-0000


Form C.P. 1

STATE OF KANSAS
STATE CORPORATION COMMISSION

WELL PLUGGING RECORD

Give All Information Completely
Make Required Affidavit
Mail or Deliver Report to
Conservation Division
State Corporation Commission

P. O. Box 17027
Wichita, Kansas 67217

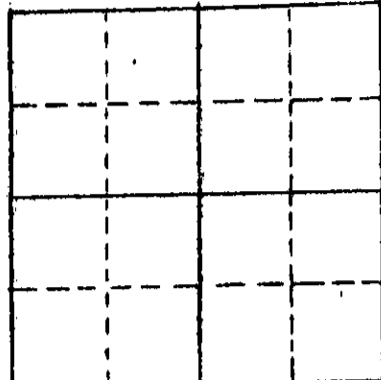

Locate well correctly on above
Section Plat

Kingman County, Sec. 20 Twp. 29S. Rge. ~~X08~~ 6 (W)
Location at "NE/CNW/SE" or footage from lines SE SE NW
Lease Owner Graves Drilling Co., Inc.
Lease Name Albright Well No. 1
Office Address 910 Union Center, Wichita, Kansas 67202
Character of Well (completed as Oil, Gas or Dry Hole)
Date well completed April 26 19 76
Application for plugging filed April 26 19 76
Application for plugging approved April 26 19 76
Plugging commenced April 26 19 76
Plugging completed April 26 19 76
Reason for abandonment of well or producing formation

If a producing well is abandoned, date of last production 19
Was permission obtained from the Conservation Division or its agents before plugging was commenced?

Name of Conservation Agent who supervised plugging of this well G. R. Biberstein, Attica, Kansas
Producing formation Depth to top Bottom Total Depth of Well Feet
Show depth and thickness of all water, oil and gas formations.

OIL, GAS OR WATER RECORDS

CASING RECORD

FORMATION	CONTENT	FROM	TO	SIZE	PUT IN	PULLED OUT
				8 5/8	210'	None

Describe in detail the manner in which the well was plugged, indicating where the mud fluid was placed and the method or methods used in introducing it into the hole. If cement or other plugs were used, state the character of same and depth placed, from feet to feet for each plug set.

Filled hole with heavy mud to 200 feet. Pumped 35 sacks of cement through drill pipe with pump truck. Pushed plug and 1/2 sack bulls to 40' and pumped 15 sacks of cement through drill pipe with pump truck to base of well cellar. Plugged rat hole with 2 sacks of cement.

5-4-76

(If additional description is necessary, use BACK of this sheet)

Name of Plugging Contractor Graves Drilling Co., Inc.
Address 910 Union Center, Wichita, Kansas

STATE OF KANSAS COUNTY OF SEDGWICK ss.
John C. Graves (employee of owner) or (owner or operator) of the above-described well, being first duly sworn on oath, says: That I have knowledge of the facts, statements, and matters herein contained and the log of the above-described well as filed and that the same are true and correct. So help me God.

(Signature) [Signature]
910 Union Center, Wichita, Kansas 67202
(Address)

Subscribed and Sworn to before me this 3rd day of May 1976

My commission expires May 9, 1979
Betty Brandt Notary Public

15095-204800000

ROTARY DRILLERS' LOG

OPERATOR: Graves Drilling Co., Inc.
910 Union Center
Wichita, Kansas 67202

DRILLING COMMENCED: 19 April 1976

CONTRACTOR: Graves Drilling Co., Inc.
910 Union Center
Wichita, Kansas 67202

DRILLING COMPLETED: 26 April 1976

CASING RECORD: 5 Jts. 210' of used 8-5/8"
cemented with 225 sacks

LOCATION: Albright No. 1
SE SE NW
Section 20-29S-6W
Kingman County, Kansas

0 - 210	Sand & shale
210 - 567	Sand
567 - 1340	Shale & sand
1340 - 1630	Shale & shells
1630 - 1933	Shale
1933 - 2176	Shale & shells
2176 - 3385	Shale
3385 - 3665	Shale & lime
3665 - 3975	Lime & shale
3975 - 4200	Lime
4200	Rotary Total Depth

GRAVES DRILLING CO., INC.
WICHITA, KANSAS

I hereby certify the foregoing statements to be true and correct to the best of my knowledge.

GRAVES DRILLING CO., INC.

By John C. Graves
President

STATE OF KANSAS)
) SS:
SEDGWICK COUNTY)

Subscribed and sworn to before me, a Notary Public, this 3rd day of May, 1976

My commission expires: 2 February 1980

Courtney M. Graves
Notary Public
Courtney M. Graves

