


STATE CORPORATION COMMISSION  
 Give All Information Completely  
 Make Required Affidavit  
 Mail or Deliver Report to:  
 Conservation Division  
 State Corporation Commission  
 800 Biting Building  
 Wichita, Kansas

15-169-00916-00-00  
**WELL PLUGGING RECORD**

Saline County, Sec. 3 Twp. 16S Rge. 3W (E) (W)  
 Location as "NE/CNWSW" or footage from lines QW/2 SE NE  
 Lease Owner J. E. Spaeth, Operator  
 Lease Name Burmeister Well No. 2  
 Office Address Box 569, Salina, Kansas  
 Character of Well (completed as Oil, Gas or Dry Hole) Oil Well  
 Date well completed April 12, 1951 19  
 Application for plugging filed June 3, 1953 19  
 Application for plugging approved June 5, 1953 19  
 Plugging commenced June 24, 1953 19 ✓  
 Plugging completed June 29, 1953 19  
 Reason for abandonment of well or producing formation oil depleted

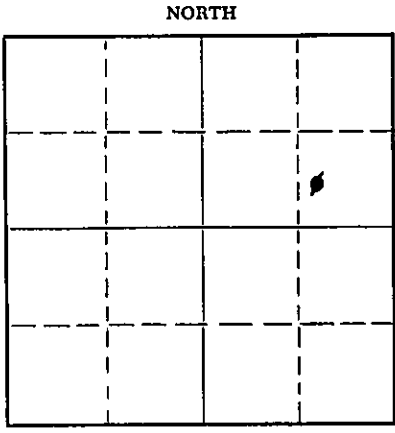

Locate well correctly on above Section Plat

If a producing well is abandoned, date of last production \_\_\_\_\_ 19  
 Was permission obtained from the Conservation Division or its agents before plugging was commenced? Yes

Name of Conservation Agent who supervised plugging of this well Ruel Durkee  
 Producing formation \_\_\_\_\_ Depth to top \_\_\_\_\_ Bottom \_\_\_\_\_ Total Depth of Well 3378 Feet  
 Show depth and thickness of all water, oil and gas formations. 3378

**OIL, GAS OR WATER RECORDS**

**CASING RECORD**

FORMATION	CONTENT	FROM	TO	SIZE	PUT IN	PULLED OUT
				8-5/8"	320	
				5-1/2"	3303'	2840' ✓

Describe in detail the manner in which the well was plugged, indicating where the mud fluid was placed and the method or methods used in introducing it into the hole. If cement or other plugs were used, state the character of same and depth placed, from \_\_\_\_\_ feet to \_\_\_\_\_ feet for each plug set.

Plugged back with sand to 3280 feet. Dumped 6 sax cement at 3280 feet with dump bailer. Top of cement 3238 feet. Filled hole with mud to 175 feet. Dumped 15 sacks of cement. Top of cement 130 feet. Filled with mud to 20 feet, set rock bridge and dumped 5 sax cement for cap.

(If additional description is necessary, use BACK of this sheet)

Name of Plugging Contractor J & M Casing Pulling Company  
 Address Great Bend, Kansas

STATE OF Kansas COUNTY OF Salina, ss.  
J. E. Spaeth (employee of owner) or (owner or operator) of the above-described well, being first duly sworn on oath, says: that I have knowledge of the facts, statements, and matters herein contained and the log of the above-described well as filed and that the same are true and correct. So help me God  
 (Signature) J. E. Spaeth  
405 E Park Lane  
 (Address)

SUBSCRIBED AND SWORN TO before me this 23 day of July, 1953

My Commission Expires March 25, 1957

My commission expires \_\_\_\_\_

G. H. [Signature] Notary Public.

**PLUGGING**  
 FILE SEC 3 T 16 R 3W  
 BOOK PAGE 106 LINE 14

24-7368-8 3-53-20M

STATE CORPORATION COMMISSION  
 CONSERVATION DIVISION  
 Wichita, Kansas

15-169-00916-00-00

# STERLING DRILLING CO.

STERLING, KANSAS

WELL 100 - - - - - BURMEISTER #2

Location - C W/2 SE/4 NE/4 of Section 3-16-3, Saline County, Kansas

Owner - Speath Brothers  
Rotary Drilling Contractor - Sterling Drilling Company  
Cable Tools Contractor - Sterling Drilling Company

Commenced - 2-27-51  
Completed - 3-11-51 (w/r)  
              - 4-12-51 (w/c.t.)

Total Depth - 3378' (w/r)  
              - 3390' (w/c.t.) (P.B.D. 3316')

COPY

### LOG

0- 100	Clay and Shale
100- 260	Shale and Shells
260- 280	Lime
280- 310	Shale and Shells
0- 320	12"
310- 340	Anhydrite
340- 405	Lime, Shale and Shells
405-1015	Shale and Lime
1015-1690	Shale and Shells
1690-2480	Lime and Shale
2480-2575	Shale
2575-2805	Lime
2805-3060	Lime
3060-3285	Shale
3285-3370	Lime
3378-3390	Viola Lime

### CASING RECORD

120' of 8-5/8" Surface Pipe  
Cemented with 200 Sacks Cement  
  
3303' of 5 1/2" O. D. Casing  
Cemented with 60 Sacks Cement  
(set at 3286')

PRODUCTION: Producer

CABLE TOOL RECORD: Plugged back to 3316'. Acidized with 1,000 gal. 15% acid at 3316'. Very small show of oil.  
Dumped 1,800 gal. white gasoline, Pumped it down with oil. Maximum pressure 450#. Swabbing test showed 4 1/2 bbls. of oil in 3 hours.

**RECEIVED**  
STATE CORPORATION COMMISSION  
CONSERVATION DIVISION  
Wichita, Kansas

**PLUGGING**  
FILE SEC 3 T No. 3w  
BOOK PAGE 166 LINE 14