


STATE OF KANSAS
 STATE CORPORATION COMMISSION
 Give All Information Completely
 Make Required Affidavit
 Mail or Deliver Report to:
 Conservation Division
 State Corporation Commission
 212 North Market, Insurance Bldg.
 Wichita, Kansas

15-169-00043-00-00
WELL PLUGGING RECORD

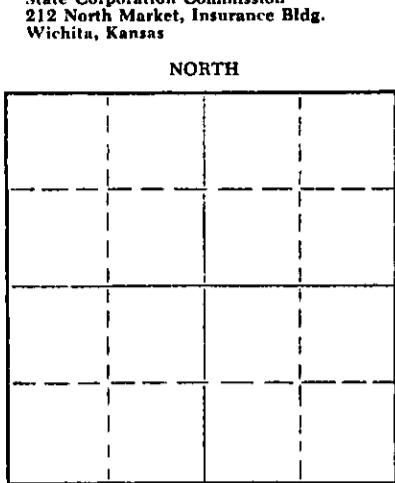

Locate well correctly on above Section Plat

Saline County. Sec. 2 Twp. 16 Rge. 3 (E) W (W)
 Location as "NE/CNWXSWX" or footage from lines SW SW NW
 Lease Owner Tom Brown
 Lease Name Bjorklund Well No. 1
 Office Address Lindsborg, Kansas
 Character of Well (completed as Oil, Gas or Dry Hole) _____
 Date well completed _____ 19____
 Application for plugging filed _____ 19____
 Application for plugging approved _____ 19____
 Plugging commenced 12-4-60 _____ 19____
 Plugging completed 12-5-60 _____ 19____
 Reason for abandonment of well or producing formation Depleted.

If a producing well is abandoned, date of last production _____ 19____
 Was permission obtained from the Conservation Division or its agents before plugging was commenced? yes

Name of Conservation Agent who supervised plugging of this well Gilbert Toman
 Producing formation _____ Depth to top _____ Bottom _____ Total Depth of Well 3385 Feet
 Show depth and thickness of all water, oil and gas formations.

OIL, GAS OR WATER RECORDS				CASING RECORD		
FORMATION	CONTENT	FROM	TO	SIZE	PUT IN	PULLED OUT
				8-5/8"	285'	None
				5-1/2"	3385'	2842'

Describe in detail the manner in which the well was plugged, indicating where the mud fluid was placed and the method or methods used in introducing it into the hole. If cement or other plugs were used, state the character of same and depth placed, from _____ feet to _____ feet for each plug set.

Checked hole to 3385' and found it clear. Sanded hole from 3385' to 3370' and dumped 5 sacks of cement with dump bailer @ 3370'. Pulled 5 1/2" casing. Mudded hole to 240', set 10' rock bridge to 230' and ran 20 sacks of cement @ 230'. Mudded hole to 40', set 10' rock bridge to 30' and ran 10 sacks of cement to base of cellar.

PLUGGING COMPLETE.

1-13-61
 CON. DIVISION

(If additional description is necessary, use BACK of this sheet)
 Name of Plugging Contractor KNIGHT CASING PULLING CO.
 Address CHASE, KANSAS

STATE OF KANSAS COUNTY OF RICE, ss.
Noel J. Knight (employee of owner) or (~~owner or operator~~) of the above-described well, being first duly sworn on oath, says: That I have knowledge of the facts, statements, and matters herein contained and the log of the above-described well as filed and that the same are true and correct. So help me God.

(Signature) Noel J. Knight
Chase, Kansas
 (Address)

SUBSCRIBED AND SWORN TO before me this 6th day of December 1960

My commission expires May 20, 1964
Milton J. Volin Notary Public.