

15-169-00666-00-00

WELL PLUGGING RECORD

STATE OF KANSAS STATE CORPORATION COMMISSION


Give All Information Completely Make Required Affidavit Mail or Deliver Report to: Conservation Division State Corporation Commission 800 Blitting Building Wichita, Kansas

OR

Strike out upper line when reporting plugging of formations.

FORMATION PLUGGING RECORD

Saline County. Sec. 2 Twp. 15s Rge. 3 (E) W (W) Location as "NE 1/4 NW 1/4 SW 1/4" or footage from lines. C NW 1/4 of NW 1/4 of SE 1/4 Lease Owner Bert A. Breon Lease Name Nelson Well No. 1 Office Address 155 1/2 North Santa Fe, Salina, Kansas Character of Well (completed as Oil, Gas or Dry Hole) dry hole Date well completed July 3 19 50 Application for plugging filed July 3, 19 50 Application for plugging approved same day 19 Plugging commenced 3:30 P.M. July 3 19 50 Plugging completed 8:00 P.M. July 3 19 50 Reason for abandonment of well or producing formation dry hole

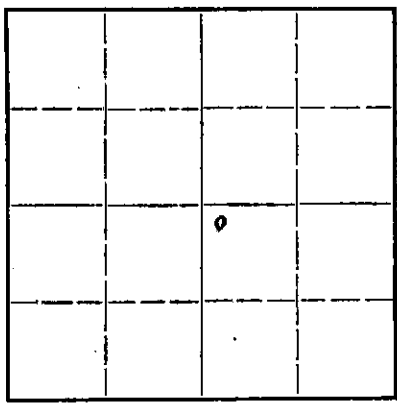

Locate well correctly on above Section Plat

If a producing well is abandoned, date of last production XXXX 19 Was permission obtained from the Conservation Division or its agents before plugging was commenced? Yes

Name of Conservation Agent who supervised plugging of this well Ruel Durkee Producing formation None Depth to top XX Bottom XX Total Depth of Well 3414 Feet Show depth and thickness of all water, oil and gas formations.

OIL, GAS OR WATER RECORDS CASING RECORD

Table with 7 columns: Formation, Content, From, To, Size, Put In, Pulled Out. Row 1: Viola Dolemite, Water, 3407, 3414, 13", 151', None. Row 2: 8 5/8", 294', XX.

Describe in detail the manner in which the well was plugged, indicating where the mud fluid was placed and the method or methods used in introducing it into the hold. If cement or other plugs were used, state the character of same and depth placed, from...feet to...feet for each plug set.

Gunned pits, circulated heavy mud on bottom and half out, filled with mud to 150'. Pushed wood plug to 150'. Filled in rock to form bridge that would hold drill pipe. Dumped in 15 sacks of cement on bridge at 150' - Filled hole to 30' with mud. Mixed five sacks cement filling hole to cellar floor.

RECEIVED

Conservation Div.

7-7-50 JUL 7 - 1950

STATE CORPORATION COMMISSION KANSAS

(If additional description is necessary, use BACK of this sheet)

Correspondence regarding this well should be addressed to Bert A. Breon Address 155 1/2 North Santa Fe, Salina, Kansas

STATE OF KANSAS, COUNTY OF SALINE, ss. Bert A. Breon (Employee or owner or operator) of the above-described well, being first duly sworn on oath, says: That I have knowledge of the facts, statements, and matters herein contained and the log of the above-described well as filed and that the same are true and correct. So help me God.

(Signature) X B.A. Breon

155 1/2 No. Santa Fe, Salina, Kansas (Address)

SUBSCRIBED AND SWORN to before me this 6th day of July, 19 50

Notary Public. (Signature)

My commission expires 2-11-54

PLUGGING FILE SEC 2T-16-R-30 800K PAGE 19 LINE 27

